


Give All Information Completely
Make Required Affidavit
Mail or Deliver Report to:
Conservation Division
State Corporation Commission
211 No. Broadway
Wichita, Kansas

WELL PLUGGING RECORD

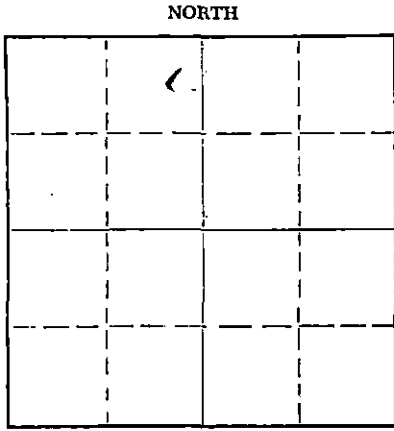

Locate well correctly on above
Section Plat

Stafford County, Sec. 36 Twp. 22S Rge. 13W (##) (W)
Location as "NE/CNW/SW" or footage from lines: Approx. SW NE NE
Lease Owner: Petroleum, Inc.
Lease Name: Tieperman "E" Well No. 1
Office Address: R. R. #2, Great Bend, Kansas
Character of Well (completed as Oil, Gas or Dry Hole): Dry Hole
Date well completed: August 22 1962
Application for plugging filed: August 22 1962
Application for plugging approved: August 22 1962
Plugging commenced: August 22 1962
Plugging completed: August 22 1962
Reason for abandonment of well or producing formation: No Produicable Formation

If a producing well is abandoned, date of last production: ----- 19---
Was permission obtained from the Conservation Division or its agents before plugging was commenced? Yes

Name of Conservation Agent who supervised plugging of this well: W. L. Lackamp Jr.
Producing formation: ----- Depth to top: ----- Bottom: ----- Total Depth of Well 3799 Feet
Show depth and thickness of all water, oil and gas formations.

OIL, GAS OR WATER RECORDS

CASING RECORD

| FORMATION | CONTENT | FROM | TO | SIZE | PUT IN | PULLED OUT |
|-----------|---------|------|----|--------|--------|------------|
| | | | | 8-5/8" | 256' | None |
| | | | | | | |
| | | | | | | |
Describe in detail the manner in which the well was plugged, indicating where the mud fluid was placed and the method or methods used in introducing it into the hole. If cement or other plugs were used, state the character of same and depth placed, from ~~****~~ feet to ----- feet for each plug set.

Mudded up with heavy mud to 160' followed by a wooden plug and 1/4 sacks of hulls. Placed 20 sacks of cement on top top of hulls through drill pipe. Mudded up with heavy mud to 40' followed by a wooden plug and 1/4 sacks hulls. Placed 12 sacks cement on top of hulls to base of well cellar.

RECEIVED
STATE CORPORATION COMMISSION

AUG 31 1962

CONSERVATION DIVISION
Wichita, Kansas

P-31-62

(If additional description is necessary, use BACK of this sheet)

Name of Plugging Contractor: Garvey Drilling Co.
Address: R.R.#2, Great Bend, Kansas

STATE OF Kansas, COUNTY OF Barton, ss.
Don Searle (employee of owner) or (#####) of the above-described well, being first duly sworn on oath, says: That I have knowledge of the facts, statements, and matters herein contained and the log of the above-described well as filed and that the same are true and correct. So help me God. Don Searle, Dist. Production

(Signature) Don Searle
R.R. #2, Great Bend, Kansas
(Address)

SUBSCRIBED AND SWORN TO before me this 29th day of August, 1962

My commission expires April 11, 1963

Arthur J. Miles
Notary Public.



WELL LOG

15-185.11355-0000

COMPANY PETROLEUM, INCORPORATED

SEC. 36 T. 22S R. 13W

FARM TIEPERMANN "E" NO. 1

LOC. Approx. SW, NE, NE


TOTAL DEPTH 3799'

COUNTY STAFFORD CO., KANSAS

COMM. August 14, 1962 COMP. August 22, 1962

CONTRACTOR GARVEY DRILLING COMPANY

CASING 8-5/8" @ 256' w/200 sax.

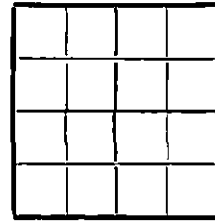

ELEVATION 1880' DF

PRODUCTION D & A

FIGURES INDICATE BOTTOM OF FORMATIONS

| | |
|------|----------------------------|
| 210 | Surface clay, sand & shale |
| 715 | Red bed |
| 750 | Anhydrite |
| 1690 | Shale & lime |
| 1815 | Lime & shale |
| 2190 | Lime |
| 3040 | Shale & lime |
| 3237 | Lime & shale |
| 3405 | Shale & lime |
| 3672 | Lime |
| 3730 | Lime & chert |
| 3780 | Shale & sand |
| 3799 | Lime |
| 3799 | T. D. |

RECEIVED
 STATE CORPORATION COMMISSION
 AUG 21 1962
 CONSERVATION DIVISION
 Wichita, Kansas

State of KANSAS }
 County of BARTON } ss

I, VERNE A. MORRIS of GARVEY DRILLING COMPANY
 upon oath state the above and foregoing is a true and correct copy of the log of the #1 TIEPERMANN "E" well.

Subscribed and sworn to before me this 28th day of August 19 62

My Commission Expires: April 14, 1963

Verne A. Morris
Arthur J. Wiles
 NOTARY PUBLIC