


Give All Information Completely
Make Required Affidavit
Mail or Deliver Report to:
Conservation Division
State Corporation Commission
800 Bittling Building
Wichita, Kansas

WELL PLUGGING RECORD

NORTH

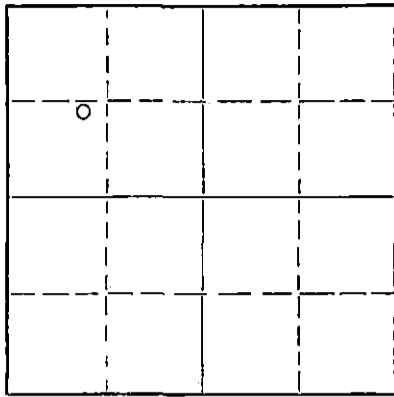

Locate well correctly on above
Section Plat

Stafford County. Sec. 34 Twp. 22 Rge. (E)13 (W)

Location as "NE/CNW/SW" or footage from lines NE SW NW
Lease Owner Westgate-Greenland Oil Company
Lease Name Harris Well No. 2
Office Address 1009 Central Building, Wichita 2, Kansas
Character of Well (completed as Oil, Gas or Dry Hole) dry hole
Date well completed November 4, 1952 19
Application for plugging filed November 4, 1952 (orally) 19
Application for plugging approved November 4, 1952 " 19
Plugging commenced November 5, 1952 19
Plugging completed November 5, 1952 19
Reason for abandonment of well or producing formation _____

If a producing well is abandoned, date of last production _____ 19
Was permission obtained from the Conservation Division or its agents before plugging was commenced? yes

Name of Conservation Agent who supervised plugging of this well M. A. Rives
Producing formation _____ Depth to top _____ Bottom _____ Total Depth of Well 3882 Feet
Show depth and thickness of all water, oil and gas formations.

OIL, GAS OR WATER RECORDS

CASING RECORD

FORMATION	CONTENT	FROM	TO	SIZE	PUT IN	PULLED OUT
surface		0	296	8 5/8"	296	none

Describe in detail the manner in which the well was plugged, indicating where the mud fluid was placed and the method or methods used in introducing it into the hole. If cement or other plugs were used, state the character of same and depth placed, from _____ feet to _____ feet for each plug set.
Filled hole with heavy mud from 3882 to 270 feet.
Set plug at 270 feet and ran 20 sacks cement to 210 feet.
Filled hole with heavy mud from 210 feet to 35 feet.
Set plug at 35 feet and capped with 10 sacks cement.

(If additional description is necessary, use BACK of this sheet)

Name of Plugging Contractor Westgate Drilling Corporation
Address 1009 Central Building, Wichita 2, Kansas

STATE OF Kansas, COUNTY OF Sedgwick, ss.
_____, (employee of owner) or (owner or operator) of the above-described well, being first duly sworn on oath, says: That I have knowledge of the facts, statements, and matters herein contained and the log of the above-described well as filed and that the same are true and correct. So help me God.

(Signature) Clair Sheatz
1009 Central Building, Wichita, Kansas
(Address)

SUBSCRIBED AND SWORN TO before me this _____ day of November, 1952
Esther Russell
Notary Public.

My commission expires May 25, 1953.

24-2675-5 2-52-20M

PLUGGING
FILE SEC. 34 Twp. 22 R. 13 W.
BOOK PAGE 27 LINE 76

NOV 11 1952 11-11-52
CONSERVATION DIVISION
Wichita, Kansas

COMPANY: Westgate-Greenland Oil Co
 CONTRACTOR: Westgate Drilling Corporation
 FARM: Harris #2
 LOCATION: NE SW NW Section 34-22S-13W
 Stafford County, Kansas
 COMMENCED: October 24, 1952
 COMPLETED: November 4, 1952
 ELEVATION: 1910 DF

 0 to 150 Sand and shale
 150 to 295 Shale
 295 to 600 Shale, sand and red bed
 600 to 765 Red bed
 765 to 795 Anhydrite
 795 to 1340 Shale and shells
 1340 to 1560 Shale and salt
 1560 to 1680 Shale, shells
 1680 to 1780 Lime W/shale
 1780 to 2065 Lime
 2065 to 2750 Shale and lime
 2750 to 2830 Lime W/shale streaks
 2830 to 3254 Lime and shale
 3254 to 3300 Lime
 3300 to 3380 Lime and shale
 3380 to 3428 Shale
 3428 to 3705 Lime
 3705 to 3723 Lime and shale
 3723 to 3743 Lime and chert
 3743 to 3819 Lime
 3819 to 3853 Shale
 3853 to 3857 Shale and sand
 3857 to 3882 Arbuckle lime
 3882 T. D. (RB)

Set 296 feet of 8 5/8" 24# surface pipe. Cemented with 225 sacks cement and 3 sacks calcium chloride.

TOPS: Anhydrite 763 Lansing 3444 Simpson 3803
 Heebner 3292 Base KC 3701 Arbuckle 3855
 Brown Lime 3425 Viola 3742

Drill Stem Tests: 3502-43, open 1 hour, fair blow for the hour, rec. 175' muddy salt water BHP 990#.
 3562-98, open 1 hour, rec. 12' mud, BHP 110#.

Run Schlumberger
 DRY, PLUGGED AND ABANDONED

C E R T I F I C A T E

I, _____, do hereby certify that the above and foregoing is a true and correct copy of the log of the Harris No. 2, NE SW NW of Section 34-22S-13W, Stafford County, Kansas, as reflected by files of the Westgate Drilling Corporation.

Clarence Sheats

Subscribed and sworn to before me, a Notary Public, within and for Sedgwick County, Kansas, this 5th day of November, 1952.

Esther Unsell
 Esther Unsell, Notary Public

My commission expires May 25, 1953.

PLUGGING
 FILE SEC-34-22-13W
 BOOK PAGE-57 LINE-22