


WELL PLUGGING RECORD

Give All Information Completely
Make Required Affidavit
Mail or Deliver Report to:
Conservation Division
State Corporation Commission
800 Bittling Building
Wichita, Kansas

Stafford County. Sec. 34 Twp. 22 Rge. (E) 13 (W)

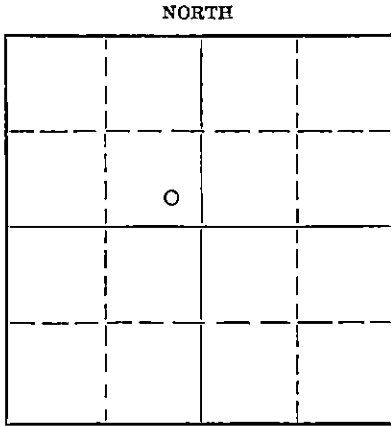

NORTH

Locate well correctly on above
Section Plat

Location as "NE/CNW $\frac{1}{4}$ SW $\frac{1}{4}$ " or footage from lines SE SE NW
Lease Owner Jackson Drilling Corporation
Lease Name Harris Well No. 1
Office Address 1009 Central Building, Wichita 2, Kansas
Character of Well (completed as Oil, Gas or Dry Hole) SE SE NW
Date well completed July 30, 1952 19
Application for plugging filed July 30, 1952 (orally) 19
Application for plugging approved July 31, 1952 19
Plugging commenced July 30, 1952 19
Plugging completed July 30, 1952 19
Reason for abandonment of well or producing formation

If a producing well is abandoned, date of last production 19
Was permission obtained from the Conservation Division or its agents before plugging was commenced? Yes

Name of Conservation Agent who supervised plugging of this well M. A. Rives
Producing formation Depth to top Bottom Total Depth of Well Feet
Show depth and thickness of all water, oil and gas formations.

OIL, GAS OR WATER RECORDS

CASING RECORD

Formation	Content	From	To	Size	Put In	Pulled Out
Surface		0	271	8 5/8"	271	none

Describe in detail the manner in which the well was plugged, indicating where the mud fluid was placed and the method or methods used in introducing it into the hole. If cement or other plugs were used, state the character of same and depth placed, from feet to feet for each plug set.

Filled hole with heavy mud from 3902 to 270 feet,
Plug at 270 feet and ran 20 sacks cement to 230 feet,
Filled hole with heavy mud from 230 feet to 35 feet,
Plug at 35 feet and ran 10 sacks cement to cellar.

8-4-52

WICHITA DIVISION
Wichita, Kansas

(If additional description is necessary, use BACK of this sheet)

Name of Plugging Contractor Jackson Drilling Corporation
Address 1009 Central Building, Wichita, 2, Kansas

STATE OF Kansas, COUNTY OF Sedgwick, SS.
Harold A. Burt (employee of owner) or (owner or operator) of the above-described well,
being first duly sworn on oath, says: That I have knowledge of the facts, statements, and matters herein contained and the log of the above-described well as filed and that the same are true and correct. So help me God.

(Signature) Harold A. Burt
1009 Central Building, Wichita, Kansas
(Address)

SUBSCRIBED AND SWORN to before me this 31st day of July, 1952
Esther Russell
Notary Public.

My commission expires May 25, 1953.

PLUGGING
FILE SEC 34 T22 R13W
BOOK PAGE 34 LINE 3

C E R T I F I C A T E

I, Don Allen, do hereby certify that the above and foregoing is a true and correct copy of log of the Harris #1, SE SE NW Section 34-22S-13W, Stafford County, Kansas, as reflected by files of the Jackson Drilling Corporation.

Don Allen
Don Allen

Subscribed and sworn to before me, a Notary Public, within and for Sedgwick County, Kansas, this 2nd day of August, 1952.

Esther Unsell
Esther Unsell, Notary Public

My commission expires May 25, 1953.

RECEIVED
STATE CORPORATION COMMISSION
AUG - 4 1952
CONSERVATION DIVISION
Wichita, Kansas