


STATE OF KANSAS  
STATE CORPORATION COMMISSION

15.081.00450.00.00  
WELL PLUGGING RECORD

Give All Information Completely  
Make Required Affidavit  
Mail or Deliver Report to:  
Conservation Division  
State Corporation Commission  
800 Biting Building  
Wichita, Kansas

Haskell County, Sec. 29 Twp. 30S Rge. 31W (E) (W)  
Location as "NE/CNWxSWx" or footage from lines SE SE NW  
Lease Owner Southwestern Exploration Company  
Lease Name Beverlin Well No. 1  
Office Address 352 North Broadway, Wichita, Kansas  
Character of Well (completed as Oil, Gas or Dry Hole) Gas  
Date well completed March 8 1955  
Application for plugging filed April 5 1956  
Application for plugging approved April 19 "  
Plugging commenced April 18 19 "  
Plugging completed April 19 19 "  
Reason for abandonment of well or producing formation not commercially productive  
If a producing well is abandoned, date of last production January 19 56  
Was permission obtained from the Conservation Division or its agents before plugging was commenced? Yes

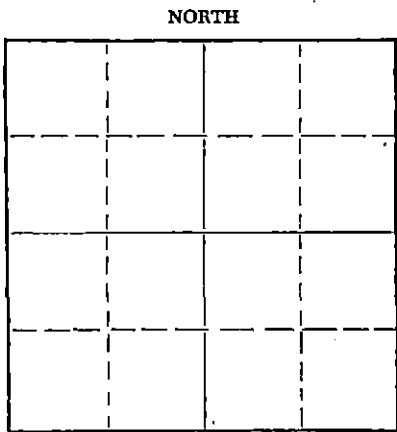

Locate well correctly on above Section Plat

Name of Conservation Agent who supervised plugging of this well Mr. Rives  
Producing formation \_\_\_\_\_ Depth to top \_\_\_\_\_ Bottom \_\_\_\_\_ Total Depth of Well 2718 Feet  
Show depth and thickness of all water, oil and gas formations.

OIL, GAS OR WATER RECORDS				CASING RECORD		
FORMATION	CONTENT	FROM	TO	SIZE	PUT IN	PULLED OUT
				10"	655	-0-
				5 1/2"	2716 1/2	607

Describe in detail the manner in which the well was plugged, indicating where the mud fluid was placed and the method or methods used in introducing it into the hole. If cement or other plugs were used, state the character of same and depth placed, from \_\_\_\_\_ feet to \_\_\_\_\_ feet for each plug set.

Took tension on 5 1/2" casing and removed slips from bradenhead in cellar. Worked casing and had 7" tension. Mudded the hole from 2600' to 1000' and shot pipe at 1020', 901', 797', 705' and 611'. Pipe came loose. Pulled 19 joints. Bailed fluid to 600', set a 10' rock bridge and pumped in 25 sacks of cement which filled to 550'. Mudded the hole from 550' to 35', set a 10' rock bridge and pumped in 10 sacks of cement to fill to base of cellar.

(If additional description is necessary, use BACK of this sheet)  
Name of Plugging Contractor West Supply Company  
Address Chase, Kansas

STATE OF KANSAS, COUNTY OF SEDGWICK, ss.  
M. S. Davis (employee of owner) or ~~owner or operator~~ of the above-described well, being first duly sworn on oath, says: That I have knowledge of the facts, statements, and matters herein contained and the log of the above-described well as filed and that the same are true and correct. So help me God.

(Signature) M. S. Davis  
352 North Broadway, Wichita, Kansas  
(Address)

SUBSCRIBED AND SWORN TO before me this 3 day of May, 19 56  
Jeanette Halmer Spence Notary Public.

My commission expires 10/28/1959

RECEIVED  
STATE CORPORATION COMMISSION  
MAY 11 1956  
5-4-56  
CONSERVATION DIVISION  
Wichita, Kansas

PLUGGING  
FILE SEC 29 T 30 R 31W  
BOOK PAGE 57 LINE 6