


STATE OF KANSAS
STATE CORPORATION COMMISSION

10107

~~15.081.10701.00.00~~
WELL PLUGGING RECORD

Give All Information Completely
Make Required Affidavit
Mail or Deliver Report to:
Conservation Division
State Corporation Commission
800 Bittling Building
Wichita, Kansas

NORTH

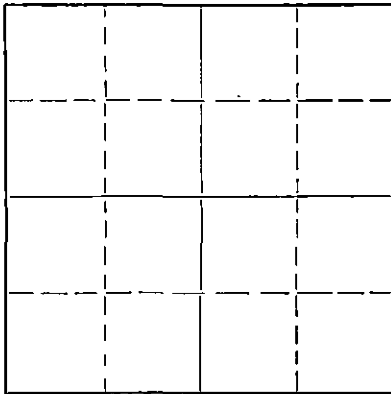

Locate well correctly on above
Section Plat

Haskell County. Sec. 8 Twp. 30 Rge. 31 (X) (W)
Location as "NE/CNW/SW" or footage from lines 100' W & 1250' S of Cen. Sec.
Lease Owner American Gas Production Co.
Lease Name Ellsaesser Well No. A-1
Office Address Bartlesville, Okla.
Character of Well (completed as Oil, Gas or Dry Hole) Dry Hole
Date well completed Plugged 8-10-54 19
Application for plugging filed 8-7-54 19
Application for plugging approved 8-9-54 19
Plugging commenced 8-10-54 19
Plugging completed 8-10-54 19
Reason for abandonment of well or producing formation Dry Hole

If a producing well is abandoned, date of last production _____ 19____
Was permission obtained from the Conservation Division or its agents before plugging was commenced? Yes

Name of Conservation Agent who supervised plugging of this well Gorden Farr
Producing formation _____ Depth to top _____ Bottom _____ Total Depth of Well 5510 Feet
Show depth and thickness of all water, oil and gas formations.

OIL, GAS OR WATER RECORDS

CASING RECORD

FORMATION	CONTENT	FROM	TO	SIZE	PUT IN	PULLED OUT
				8-5/8"	524	none
	(DRY HOLE)					

Describe in detail the manner in which the well was plugged, indicating where the mud fluid was placed and the method or methods used in introducing it into the hole. If cement or other plugs were used, state the character of same and depth placed, from _____ feet to _____ feet for each plug set.

Ran Schlumberger electric and gamma ray neutron logs. 50 sacks of cement from 5510 to 5348, heavy rotary mud to 600'; 50 sacks of cement from 600' to 440'; heavy rotary mud to 30'; cement to 6' of ground level at which point the 8-5/8" casing was cut off and a steel cap was welded on.

(If additional description is necessary, use BACK of this sheet)

Name of Plugging Contractor Halliburton Cementing Co.
Address Duncan, Oklahoma


STATE OF KANSAS, COUNTY OF SEWARD, ss.
H. V. Anderson (employee of owner) or (owner or operator) of the above-described well, being first duly sworn on oath, says: That I have knowledge of the facts, statements, and matters herein contained and the log of the above-described well as filed and that the same are true and correct. So help me God.

(Signature) H. V. Anderson
Box 70, Liberal, Kansas
(Address)

SUBSCRIBED AND SWORN TO before me this 12th day of August, 1954

My commission expires 5-23-57

24-2675-S 2-52-20M

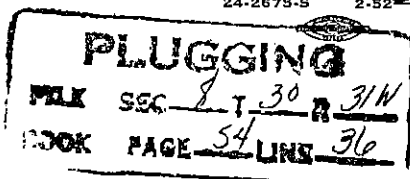

RECEIVED
STATE CORPORATION COMMISSION
AUG 13 1954 8-13-54
CONSERVATION DIVISION
Wichita, Kansas