


STATE OF KANSAS  
STATE CORPORATION COMMISSION

Give All Information Completely  
Make Required Affidavit  
Mail or Deliver Report to:  
Conservation Division  
State Corporation Commission  
211 No. Broadway  
Wichita, Kansas

15.081.00055.00.00  
WELL PLUGGING RECORD

T - 30 NORTH R - 33W

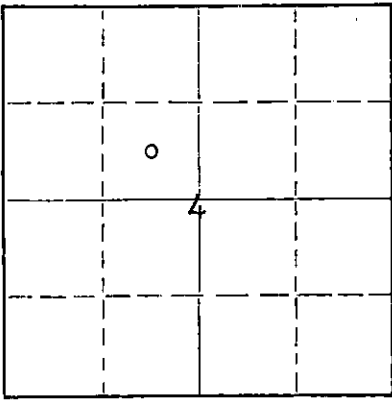

Locate well correctly on above Section Plat

Haskell County. Sec. 4 Twp. 30 Rge. 33 (E) W (W)  
Location as "NE/CNWSW" or footage from lines C SE NW  
Lease Owner ~~XXXXXX~~ Pan American Petroleum Corporation  
Lease Name Moore Gas Unit "H" Well No. 1  
Office Address ~~XXXXXX~~ Box 507, Ulysses, Kansas  
Character of Well (completed as Oil, Gas or Dry Hole) Dry  
Date well completed 12-22-61 19  
Application for plugging filed 10-8-63 19  
Application for plugging approved 10-9-63 19  
Plugging commenced 10-24-63 19  
Plugging completed ~~10-24-63~~ 10-27-63 19  
Reason for abandonment of well or producing formation ~~DEPLETION~~ No commercial quantities of oil or gas present.  
If a producing well is abandoned, date of last production None 19  
Was permission obtained from the Conservation Division or its agents before plugging was commenced? yes

Name of Conservation Agent who supervised plugging of this well Hugh Scott  
Producing formation None Depth to top Bottom Total Depth of Well 4970 5006 Feet  
Show depth and thickness of all water, oil and gas formations.

OIL, GAS OR WATER RECORDS

CASING RECORD

FORMATION	CONTENT	FROM	TOPS	SIZE	PUT IN	PULLED OUT
Council Grove			2936	8-5/8"	753'	None
Missourian			4157	5-1/2"	5007'	2354'
Lansing			4187			
Morrow			5253			
Chester			5297			
St. Genevieve			5461			

Describe in detail the manner in which the well was plugged, indicating where the mud fluid was placed and the method or methods used in introducing it into the hole. If cement or other plugs were used, state the character of same and depth placed, from \_\_\_\_\_ feet to \_\_\_\_\_ feet for each plug set.

Checked hole to 5000' and dumped 10 sacks of cement @ 5000' with dump bailer. Pulled 5 1/2" casing, set rock bridge from 700' to 690' and dumped 35 sacks of cement @ 690' with dump bailer. Mudded hole to 50', set rock bridge to 40' and ran 45 sacks of cement to base of cellar.

RECEIVED  
STATE CORPORATION COMMISSION

DEC 24 1963

12-24-63

CONSERVATION DIVISION  
Wichita, Kansas

PLUGGING COMPLETE.

(If additional description is necessary, use BACK of this sheet)  
Name of Plugging Contractor KNIGHT CASING PULLING COMPANY License #436  
Address CHASE, KANSAS

STATE OF KANSAS, COUNTY OF RICE, ss.  
Noel J. Knight (employee of owner) or (owner) of the above-described well, being first duly sworn on oath, says: That I have knowledge of the facts, statements, and matters herein contained and the log of the above-described well as filed and that the same are true and correct. So help me God.

(Signature) Noel J. Knight

Chase, Kansas

(Address)

SUBSCRIBED AND SWORN TO before me this 4th day of November, 1963

My commission expires May 20, 1964

Milton J. Tolin

Notary Public.



PAN AMERICAN PETROLEUM CORPORATION

WELL RECORD

15.081.00055.00.00

SUPPLEMENTAL (ENTER "X" WHEN APPLICABLE)

Grid for locating well correctly

LOCATE WELL CORRECTLY

LEASE Moore Gas Unit "H" WELL NO. 1

LOCATION OF WELL: 1980 FT. NORTH SOUTH OF THE 1980 FT.

EAST WEST OF THE WEST LINE OF THE NW 1/4 1/4 1/4

OF SECTION 4 TOWNSHIP 30 SOUTH RANGE 33 WEST

Haskell Kansas COUNTY STATE

ELEVATION: GR 2965 DF 2972 KB 2975

COMPLETED AS: OIL WELL GAS WELL WATER WELL DRY HOLE

DRILLING COMMENCED 10-21 19 61 COMPLETED 12-22 19 61

OPERATING COMPANY Pan American Petroleum Corporation ADDRESS Box 507, Ulysses, Kansas

OIL OR GAS SANDS OR ZONES

Table with columns: NAME, FROM, TO, NAME, FROM, TO

WATER SANDS

Table with columns: NAME, FROM, TO, WATER LEVEL, NAME, FROM, TO, WATER LEVEL

CASING RECORD (OVERALL MEASUREMENT)

LINER-SCREEN RECORD

Table with columns: CSG. SIZE, WEIGHT, DESCRIPTION, MAKE - GRADE, QUANTITY FEET, SIZE, QUANTITY FEET, SET AT TOP BOTTOM, MAKE AND TYPE

PACKER RECORD

Table with columns: SIZE, LENGTH, SET AT, MAKE AND TYPE

CEMENTING RECORD

MUDDING RECORD

Table with columns: SIZE, WHERE SET FEET, SACKS, CEMENT BRAND TYPE, METHOD, FINAL PRESS, METHOD (CABLE TOOLS), RESULTS

WHAT METHOD WAS USED TO PROTECT SANDS WHEN OUTER STRINGS WERE PULLED?

WERE BOTTOM HOLE PLUGS USED?

IF SO, STATE KIND, DEPTH SET, AND RESULTS OBTAINED

ROTARY TOOLS WERE USED FROM 0 FEET TO 5700 FEET, AND FROM FEET TO FEET

CABLE TOOLS WERE USED FROM For completion TO FEET, AND FROM FEET TO FEET

24-HOUR PRODUCTION OR POTENTIAL TEST

WATER BBLs.

IF GAS WELL, CUBIC FEET PER 24 HOURS SHUT-IN PRESSURE LBS. PER SQUARE IN.

I, THE UNDERSIGNED, BEING FIRST DULY SWORN UPON OATH, STATE THAT THIS WELL RECORD IS TRUE AND CORRECT ACCORDING TO THE RECORDS OF THIS OFFICE AND TO THE BEST OF MY KNOWLEDGE AND BELIEF.

Original Signed by

D. M. LILES

Area Supt.

SUBSCRIBED AND SWORN TO BEFORE ME THIS 12th DAY OF January, 19 62

MY COMMISSION EXPIRES December 3, 1964

NOTARY PUBLIC

R. W. Banks

FORMATION RECORD

DESCRIBE EACH FORMATION DRILLED. INDICATE THICKNESS, CONTENT AND WHETHER DRY, OR OIL, GAS, OR WATER BEARING.

FORMATION	TOP	BOTTOM	FORMATION	TOP	BOTTOM
Sand - Shale	0	700			
Redbed	700	846			
Redbed-shale-sand	846	2156			
Redbed-shale-gyp	2156	2408			
Redbed-shale	2408	2578			
Shale-Shells	2578	2916			
Lime-shale	2916	3209			
Lime	3209	3216			
Lime-shale	3216	4637			
Lime-shale-sand	4637	4740			
Lime	4740	4933			
Lime-shale	4933	5154			
Lime	5154	5252			
Lime-shale	5252	5625			
Chert-Lime	5625	5700			
TD 5700					