


STATE OF KANSAS  
STATE CORPORATION COMMISSION

Give All Information Completely  
Make Required Affidavit  
Mail or Deliver Report to:  
Conservation Division  
State Corporation Commission  
211 No. Broadway  
Wichita, Kansas

15.081.10095.00.00  
WELL PLUGGING RECORD

NORTH

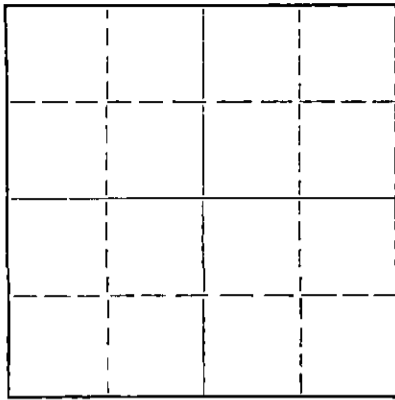

Locate well correctly on above  
Section Plat

Haskell County. Sec. 6 Twp. 30S Rge. 33W (E) (W)  
Location as "NE/CNW&SW" or footage from lines. C SW SW  
Lease Owner Helmerich & Payne, Inc.  
Lease Name Williams Well No. 1  
Office Address Box 558, Garden City, Kansas  
Character of Well (completed as Oil, Gas or Dry Hole) Dry Hole  
Date well completed March 31, 1963 19  
Application for plugging filed March 31, 1963 19  
Application for plugging approved March 31, 1963 19  
Plugging commenced March 31, 1963 19  
Plugging completed April 1, 1963 19  
Reason for abandonment of well or producing formation Dry Hole

If a producing well is abandoned, date of last production - 19  
Was permission obtained from the Conservation Division or its agents before plugging was commenced? Yes

Name of Conservation Agent who supervised plugging of this well Hugh Scott Liberal, Kansas  
Producing formation - Depth to top - Bottom - Total Depth of Well 5540 Feet  
Show depth and thickness of all water, oil and gas formations.

OIL, GAS OR WATER RECORDS

CASING RECORD

FORMATION	CONTENT	FROM	TO	SIZE	PUT IN	PULLED OUT
		4	736	10-3/4	736	None

Describe in detail the manner in which the well was plugged, indicating where the mud fluid was placed and the method or methods used in introducing it into the hole. If cement or other plugs were used, state the character of same and depth placed, from \_\_\_\_\_ feet to \_\_\_\_\_ feet for each plug set.

5540 to 2850 Heavy Rotary Mud  
2850 to 2570 100 sks Pozmix cement  
2570 to 750 Heavy Rotary Mud  
750 to 650 55 sks Pozmix cement  
650 to 40 Heavy Rotary Mud  
40 to 4 Wiper Plug & 25 sks cement  
4 to 0 Cellar

Plugging Completed at 6:45 AM, April 1, 1963

RECEIVED  
STATE CORPORATION COMMISSION

APR 3 1963

CONSERVATION DIVISION  
Wichita, Kansas

(If additional description is necessary, use BACK of this sheet)

Name of Plugging Contractor Helmerich & Payne, Inc.  
Address Utica at 21st, Tulsa, Okla.

STATE OF Kansas, COUNTY OF Finney, ss.  
T. E. Mort (employee of owner) or (~~OWNER~~) of the above-described

well, being first duly sworn on oath, says: That I have knowledge of the facts, statements, and matters herein contained and the log of the above-described well as filed and that the same are true and correct. So help me God.

(Signature) T. E. Mort

Box 558, Garden City, Kansas  
(Address)

SUBSCRIBED AND SWORN to before me this 1 day of April, 1963

My commission expires July 1964

Robert N. Boyer  
Notary Public.



well  
716

15.081.10095.00.00

Williams No. 1  
Section 6-30S-33W  
Haskell County, Kansas  
Helmerich & Payne, Inc.

Casing Record:  
13 Jts. Spiral Weld Armco & 8 Jts. 10 3/4 @ 738' w/350 sxs. Reg.  
Pozmix & 100 sxs. Reg. w/2%  
P&A

Commenced: 3-13-63  
Completed: 4-1-63

	<u>FROM</u>	<u>TO</u>
Surface	0	365
Shale	365	2805
Lime & Shale	2805	2953
Shale & Lime	2953	3300
Lime & Shale	3300	5540
<b>TOTAL DEPTH</b>		<b>5540</b>

RECEIVED  
STATE CORPORATION COMMISSION  
MAY 20 1963  
CONSERVATION DIVISION  
Wichita, Kansas

STATE OF OKLAHOMA )  
  ) SS  
County of Tulsa        )

I hereby affirm that the above and foregoing is a true and correct copy of the log of the Williams No. 1 well, located in Section 6-30S-33W, Haskell County, Kansas.

HELMERICH & PAYNE, INC.

*Ed Daniel*  
Vice President

Subscribed and sworn to before me a Notary Public this 2nd day of May, 1963.

*Margaret Lacey*  
Notary Public

My commission expires: March 30, 1964.