


Give All Information Completely
Make Required Affidavit
Mail or Deliver Report to:
Conservation Division
State Corporation Commission
211 No. Broadway
Wichita, Kansas

15.081-10175.00.00
WELL PLUGGING RECORD

T - 30 NORTH R. - 33W

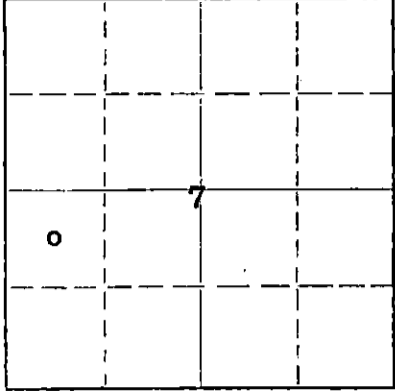

Locate well correctly on above Section Plat

Haskell County, Sec. 7 Twp. 30 Rge. 33 14 W (W)
Location as "NE/CNW/SW" or footage from lines C NW SW
Lease Owner ~~XXXXXXXXXXXX~~ Pan American Petroleum Corporation
Lease Name M. H. Williams Well No. 2
Office Address ~~XXXXXXXXXXXX~~ Box 507, Ulysses, Kansas
Character of Well (completed as Oil, Gas or Dry Hole) ~~XXXX~~ Dry Hole
Date well completed 6-14-63 19__
Application for plugging filed 10-8-63 19__
Application for plugging approved 10-9-63 19__
Plugging commenced 11-4-63 19__
Plugging completed 11-6-63 19__
Reason for abandonment of well or producing formation ~~XXXXXXXXXXXX~~ No commercial quantities of oil or gas present.
If a producing well is abandoned, date of last production None 19__
Was permission obtained from the Conservation Division or its agents before plugging was commenced? yes

Name of Conservation Agent who supervised plugging of this well Hugh Scott
Producing formation None Depth to top _____ Bottom _____ Total Depth of Well 4850 Feet
Show depth and thickness of all water, oil and gas formations.

OIL, GAS OR WATER RECORDS				CASING RECORD		
FORMATION	CONTENT	FROM	TOPS	SIZE	PUT IN	PULLED OUT
Council Grove			2904	8-5/8"	741'	None
Pennsylvanian			3294	5-1/2"	4849'	2519'
Toronto			4062			
Lansing A			4144			
Lansing B			4195			
Marmaton-Cherokee			4770			

Describe in detail the manner in which the well was plugged, indicating where the mud fluid was placed and the method or methods used in introducing it into the hole. If cement or other plugs were used, state the character of same and depth placed, from _____ feet to _____ feet for each plug set.

Checked hole, bridge @ 4850', ran 20 gal. of sand and dumped 15 sacks of cement with dump bailer. Pulled 5 1/2" casing, mudded hole to 700' and dumped 35 sacks of cement. Mudded to 50', set rock bridge to 40' and ran 15 sacks of cement to cap well.

RECEIVED
STATE CORPORATION COMMISSION

DEC 24 1963
12-24-63
CONSERVATION DIVISION
Wichita, Kansas

PLUGGING COMPLETE.

(If additional description is necessary, use BACK of this sheet)
Name of Plugging Contractor KNIGHT CASING PULLING COMPANY License #436
Address CHASE, KANSAS

STATE OF KANSAS, COUNTY OF RICE, ss.
Noel J. Knight (employee of owner) or ~~XXXXXXXXXXXX~~ of the above-described well, being first duly sworn on oath, says: That I have knowledge of the facts, statements, and matters herein contained and the log of the above-described well as filed and that the same are true and correct. So help me God.

(Signature) Noel J. Knight
Chase, Kansas
(Address)

SUBSCRIBED AND SWORN TO before me this 14th day of November, 1963

My commission expires May 20, 1964
Milton J. Volin Notary Public.



PAN AMERICAN PETROLEUM CORPORATION

WELL RECORD

SUPPLEMENTAL
(ENTER "X" WHEN APPLICABLE)

LOCATE WELL CORRECTLY

LEASE M. H. Williams WELL NO. 2

LOCATION OF WELL 1930 FT. NORTH SOUTH OF THE NORTH SOUTH LINE AND 660 FT.

EAST WEST OF THE EAST WEST LINE OF THE NW $\frac{1}{4}$ SW $\frac{1}{4}$ $\frac{1}{4}$.

OF SECTION 7 TOWNSHIP 30 NORTH SOUTH, RANGE 33 EAST WEST.

Haskell COUNTY Kansas STATE

ELEVATION: KB 2980 GL 2970 DF 2977

COMPLETED AS: OIL WELL GAS WELL WATER WELL DRY HOLE

DRILLING COMMENCED 5-23- 1963 COMPLETED 6-14 1963

OPERATING COMPANY Pan American Petroleum Corp. ADDRESS Box 507 - Wynnes, Kansas

OIL OR GAS SANDS OR ZONES

NAME	FROM	TO	NAME	FROM	TO
1 Council Grove		20730	4 Lansing "A"		4744
2 Pennsylvanian		2904	5 Lansing "B"		4195
3 Toronto		3294	6 Marmaton-Cherokee		4770
		4062			

WATER SANDS

NAME	FROM	TO	WATER LEVEL	NAME	FROM	TO	WATER LEVEL
1				3			
2				4			

CASING RECORD (OVERALL MEASUREMENT)

LINER-SCREEN RECORD

CSG. SIZE	WEIGHT	DESCRIPTION		QUANTITY FEET	SIZE	QUANTITY FEET	SET AT		MAKE AND TYPE
		THREADS	MAKE - GRADE				TOP	BOTTOM	
8 5/8"	24#	ERT	J-55	736					
5 1/2"	14#	ERT	J-55	4877					

PACKER RECORD

SIZE	LENGTH	SET AT	MAKE AND TYPE

CEMENTING RECORD

MUDDING RECORD

SIZE	WHERE SET FEET	CEMENT			METHOD	FINAL PRESS	(CABLE TOOLS)	
		SACKS	BRAND	TYPE			METHOD	RESULTS
8 5/8"	741	650	Pozmix	Bulk	Howco			
5 1/2"	4849	250	Pozmix	Bulk	Howco			

RECEIVED
STATE CORPORATION COMMISSION
DEC 24 1963

WHAT METHOD WAS USED TO PROTECT SANDS WHEN OUTER STRINGS WERE PULLED?

CONSERVATION DIVISION
Wichita, Kansas

WERE BOTTOM HOLE PLUGS USED?

IF SO, STATE KIND, DEPTH SET, AND RESULTS OBTAINED

ROTARY TOOLS WERE USED FROM 0 FEET TO 4950 FEET, AND FROM _____ FEET TO _____ FEET

CABLE TOOLS WERE USED for completion FEET TO _____ FEET, AND FROM _____ FEET TO _____ FEET

24-HOUR PRODUCTION OR POTENTIAL TEST Dry Hole

WATER _____ BBLs.

IF GAS WELL, CUBIC FEET PER 24 HOURS Dry Hole SHUT-IN PRESSURE _____ LBS. PER SQUARE IN.

I, THE UNDERSIGNED, BEING FIRST DULY SWORN UPON OATH, STATE THAT THIS WELL RECORD IS TRUE AND CORRECT ACCORDING TO THE RECORDS OF THIS OFFICE AND TO THE BEST OF MY KNOWLEDGE AND BELIEF.

ORIGINAL SIGNED BY

D. M. Liles Area Superintendent

SUBSCRIBED AND SWORN TO BEFORE ME THIS 20 DAY OF June 1963

MY COMMISSION EXPIRES 12-3-64

R. W. Banks NOTARY PUBLIC

FORMATION RECORD

DESCRIBE EACH FORMATION DRILLED. INDICATE THICKNESS, CONTENT AND WHETHER DRY, OR OIL, GAS, OR WATER BEARING.

FORMATION	TOP	BOTTOM	FORMATION	TOP	BOTTOM
Sand-red bed	0	740			
Shale	740	2676			
Shale-lime	2676	4226			
Lime	4226	4850			
Total depth	4850				
Plug back depth	4802				