


15.081.10140.00.00

WELL PLUGGING RECORD

Give All Information Completely  
Make Required Affidavit  
Mail or Deliver Report to:  
Conservation Division  
State Corporation Commission  
1101 No. Broadway  
Wichita, Kansas

T - 30 NORTH R - 33W

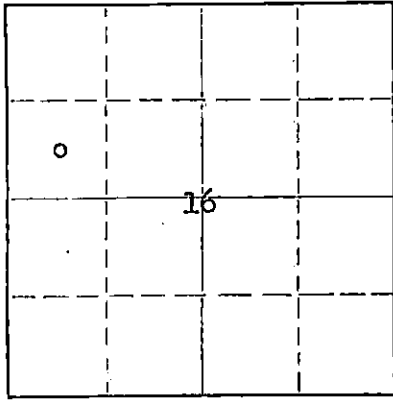

Locate well correctly on above Section Plat

Haskell County, Sec. 16 Twp. 30 Rge. 33 1/4 W (W)  
Location as "NE/CNW/SW" or footage from lines C SW NW  
Lease Owner ~~FRANK XXXX BISK~~ Pan American Petroleum Corporation  
Lease Name James O.U. "A" Well No. 2  
Office Address ~~McPherson, Kansas~~ Box 507, Ulysses, Kansas  
Character of Well (completed as Oil, Gas or Dry Hole) ~~XXXX~~ Dry hole  
Date well completed 7-6-62 19\_\_  
Application for plugging filed 10-8-63 19\_\_  
Application for plugging approved 10-9-63 19\_\_  
Plugging commenced 10-30-63 19\_\_  
Plugging completed 11-1-63 19\_\_  
Reason for abandonment of well or producing formation Depleted. No commercial quantities of oil or gas present.  
If a producing well is abandoned, date of last production None 19\_\_  
Was permission obtained from the Conservation Division or its agents before plugging was commenced? yes

Name of Conservation Agent who supervised plugging of this well Hugh Scott /PBD 4346  
Producing formation None Depth to top \_\_\_\_\_ Bottom \_\_\_\_\_ Total Depth of Well 5200 Feet  
Show depth and thickness of all water, oil and gas formations.

OIL, GAS OR WATER RECORDS

CASING RECORD

FORMATION	CONTENT	FROM	TOPS	SIZE	PUT IN	PULLED OUT
Council Grove			2920	8-5/8"	726'	None
Pennsylvanian			3296	5-1/2"	5030'	1483'
Missouri			4124			
Lansing			4143			
Des Moines			4746			

Describe in detail the manner in which the well was plugged, indicating where the mud fluid was placed and the method or methods used in introducing it into the hole. If cement or other plugs were used, state the character of same and depth placed, from \_\_\_\_\_ feet to \_\_\_\_\_ feet for each plug set.

Casing plugged back to 4346', dumped 15 sacks of cement @ 4346' with dump bailer. Pulled 5 1/2" casing to 700' and pumped in 35 sacks of cement. Pulled balance of 5 1/2" casing, mudded from 600' to 50', set rock bridge to 40' and ran 15 sacks of cement to base of cellar.

RECEIVED  
STATE CORPORATION COMMISSION

DEC 21 1963

PLUGGING COMPLETE.

CONSERVATION DIVISION  
Wichita, Kansas

12-24-63

(If additional description is necessary, use BACK of this sheet)  
Name of Plugging Contractor KNIGHT CASING PULLING COMPANY License #436  
Address CHASE, KANSAS

STATE OF KANSAS, COUNTY OF RICE, ss.  
Noel J. Knight (employee of owner) or (~~SWORN OPERATOR~~) of the above-described well, being first duly sworn on oath, says: That I have knowledge of the facts, statements, and matters herein contained and the log of the above-described well as filed and that the same are true and correct. So help me God.

(Signature) Noel J. Knight

Chase, Kansas  
(Address)

SUBSCRIBED AND SWORN TO before me this 8th day of November, 1963

Milton J. Volin

Notary Public

My commission expires May 20, 1964



PAN AMERICAN PETROLEUM CORPORATION

WELL RECORD

SUPPLEMENTAL (ENTER "X" WHEN APPLICABLE)

Grid for locating the well correctly.

LOCATE WELL CORRECTLY

LEASE James Operating Unit - Royalty Acct. A WELL NO. 2

LOCATION OF WELL: 1980 FT. NORTH SOUTH OF THE NORTH SOUTH LINE AND 660 FT.

EAST WEST OF THE EAST WEST LINE OF THE SW NW 1/4 1/4 1/4

OF SECTION 16 TOWNSHIP 30 NORTH SOUTH RANGE 33 EAST WEST

Haskell Kansas COUNTY STATE

ELEVATION: KB 2969 DT 2966 GL 2958

COMPLETED AS: OIL WELL GAS WELL WATER WELL DRY HOLE

DRILLING COMMENCED 6-5-62 COMPLETED 7-6-62 1962

OPERATING COMPANY Pan American Petroleum Corporation ADDRESS Box 507 - Ulysses, Kansas

OIL OR GAS SANDS OR ZONES

Table with columns for NAME, FROM, TO, and SANDS/ZONES.

WATER SANDS

Table with columns for NAME, FROM, TO, and WATER LEVEL.

CASING RECORD (OVERALL MEASUREMENT)

LINER SCREEN RECORD

Tables for Casing and Liner Screen records with columns for size, weight, description, and quantity.

PACKER RECORD

Table for Packer Record with columns for size, length, set at, and make and type.

CEMENTING RECORD

MUDDING RECORD

Tables for Cementing and Mudding records with columns for size, where set, cement, method, and final press.

WHAT METHOD WAS USED TO PROTECT SANDS WHEN OUTER STRINGS WERE PULLED?

WERE BOTTOM HOLE PLUGS USED?

IF SO, STATE KIND, DEPTH SET, AND RESULTS OBTAINED.

ROTARY TOOLS WERE USED FROM 0 FEET TO 5200 FEET, AND FROM FEET TO FEET

CABLE TOOLS WERE USED FROM for completion FEET TO FEET, AND FROM FEET TO FEET

24-HOUR PRODUCTION OR POTENTIAL TEST Dry Hole

WATER BBLs.

IF GAS WELL, CUBIC FEET PER 24 HOURS SHUT-IN PRESSURE LBS. PER SQUARE IN.

I, THE UNDERSIGNED, BEING FIRST DULY SWORN UPON OATH, STATE THAT THIS WELL RECORD IS TRUE AND CORRECT ACCORDING TO THE RECORDS OF THIS OFFICE AND TO THE BEST OF MY KNOWLEDGE AND BELIEF.

Original Signed by D. M. LILES Area Superintendent

SUBSCRIBED AND SWORN TO BEFORE ME THIS 18 DAY OF July 1962

MY COMMISSION EXPIRES 12-3-64 R. W. Banks NOTARY PUBLIC

FORMATION RECORD

DESCRIBE EACH FORMATION DRILLED. INDICATE THICKNESS, CONTENT AND WHETHER DRY, OR OIL, GAS, OR WATER BEARING.

FORMATION	TOP	BOTTOM	FORMATION	TOP	BOTTOM
SurfaceClay-sand-redbed	0	500			
Sand-red bed	500	1106			
Shale	1106	2547			
Shale-lime	2547	3442			
Shale	3442	3630			
Shale-Lime	3630	4456			
Lime	4456	4571			
Lime-shale	4571	5169			
Lime	5169	5200			
Total depth	5200				
Plug back depth	4346				