


WELL PLUGGING RECORD

All Information Completely
Make Required Affidavit
Mail or Deliver Report to:
Conservation Division
State Corporation Commission
211 No. Broadway
Wichita, Kansas

HASKELL County. Sec. 6 Twp. 30S Rge. (E) 34 (W)

Location as "NE/CNW4SW4" or footage from lines C SE NE
Lease Owner ASHLAND OIL & REFINING COMPANY
Lease Name H. L. THRELKELD Well No. 2
Office Address 720 NW 50TH ST., BOX 18695, OKLA. CITY, OKLA. 73118
Character of Well (completed as Oil, Gas or Dry Hole) DRYHOLE
Date well completed OCTOBER 3, 19 65
Application for plugging filed OCTOBER 28, 19 65
Application for plugging approved OCTOBER 29, 19 65
Plugging commenced NOVEMBER 1, 19 65
Plugging completed NOVEMBER 1, 19 65
Reason for abandonment of well or producing formation DRYHOLE

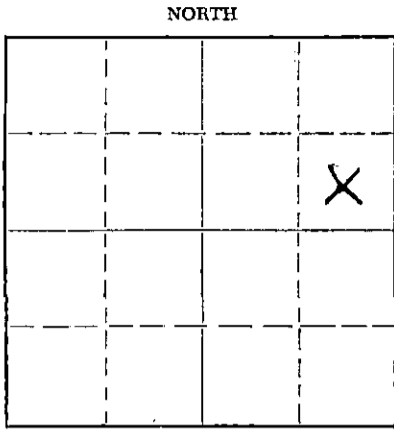

Locate well correctly on above
Section Plat

If a producing well is abandoned, date of last production NONE 19
Was permission obtained from the Conservation Division or its agents before plugging was commenced? YES

Name of Conservation Agent who supervised plugging of this well HUGH SCOTT
Producing formation ----- Depth to top ----- Bottom ----- Total Depth of Well 5,737 Feet
Show depth and thickness of all water, oil and gas formations.

OIL, GAS OR WATER RECORDS

CASING RECORD

FORMATION	CONTENT	FROM	TO	SIZE	PUT IN	PULLED OUT
DRYHOLE				8-5/8"	813 Ft.	NONE
				4-1/2"	3,192 Ft.	2,000 Ft.

Describe in detail the manner in which the well was plugged, indicating where the mud fluid was placed and the method or methods used in introducing it into the hole. If cement or other plugs were used, state the character of same and depth placed, from ----- feet to ----- feet for each plug set.

CAST IRON PLUG AT 2940 Ft. 20 SACKS CEMENT PLUG FROM 2600 Ft. to 2860 Ft.
CEMENT PLUG PUMPED DOWN. SHOT PIPE OFF AT 2000 Ft. SPOTTED 35 SACKS CEMENT
PLUG THROUGH CASING FROM 600 Ft. to 700 Ft. SET 15 SACKS CEMENT PLUG FROM
SURFACE TO 45 Ft. 8-5/8" CASING CUT OFF 3 Ft. BELOW GROUND LEVEL AND CAPPED
WITH STEEL PLATE.

11-8-65

RECEIVED
STATE CORPORATION COMMISSION

RECEIVED
STATE CORPORATION COMMISSION

NOV 8 1965

NOV 4 1965

CONSERVATION DIVISION
WICHITA, KANSAS

CONSERVATION DIVISION
WICHITA, KANSAS

(If additional description is necessary, use BACK of this sheet)
Name of Plugging Contractor SARGANT'S CASING PULLING SERVICE (LICENSE NO. 511)
Address P. O. BOX 506, LIBERAL, KANSAS

STATE OF OKLAHOMA, COUNTY OF OKLAHOMA, ss.
JACK D. COOK, STAFF ENGINEER (employee of owner) or (owner or operator) of the above-described well, being first duly sworn on oath, says: That I have knowledge of the facts, statements, and records contained and the log of the above-described well as filed and that the same are true and correct. So help me God.

(Signature) *Jack D. Cook*, STAFF ENGINEER

720 NW 50TH ST., BOX 18695, OKLA. CITY, OKLAHOMA 73118
(Address)

SUBSCRIBED AND SWORN TO before me this 3RD day of NOVEMBER, 19 65

Don W. Cox, DON W. COX
Notary Public.

My commission expires NOVEMBER 30, 1966.



THRELKELD
Q SE NE
SEC.6-30S-34W
Haskell County, Kansas

Set 8-5/8" @813 KB. 600 Sx
cement, Circulate

Set 4-1/2" @3192' 300 SX
Cement


Sand & Red Bed	0-715
Red Bed & Gyp	715-814
Red Bed	814-1132
Sand-Shale-Shells	1132-1960
Shale & Anhydrite	1960-2652
Lime & Shale	2652-3147
Lime -Shale	3147-3537
Shale-Lime-Chalk	3537-3736
Shale-Lime-Chalk	3736-3915
zLime-Shale	3915-4020
Lime	4020-4147
Lime-Chert	4147-4215
Lime	4215-5183
Lime-Shale	5183-5282
Lime-Shale-Sand	5282-5400
Lime-Shale	5400-5489
Sand & Lime	5489-5535
Lime-Shale	5535-5650
Lime	5650-5735
TD	5735

This is a true and exact copy of the formation ~~map~~ taken from
The Daily ~~Drilling~~ Reports.


T. W. Mahoney, President

State of Kansas
County of Seward

Sworn to before me this 18 Day of September, 1965.


George W. Carnahan, Jr.
Notary Public

My Commission expires January 24, 1968

RECEIVED
STATE CORPORATION COMMISSION
NOV 8 1965
CONSERVATION DIVISION
Wichita, Kansas