


STATE CORPORATION COMMISSION

Give All Information Completely
 Make Required Affidavit
 Mail or Deliver Report to:
 Conservation Division
 State Corporation Commission
 211 No. Broadway
 Wichita, Kansas

NO 15.083.00042.00.00 sec
WELL PLUGGING RECORD

NORTH

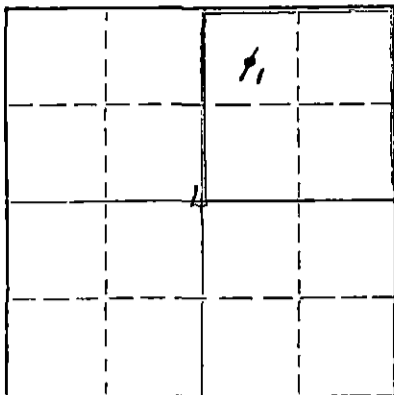

Locate well correctly on above Section Plat

Hodgeman County. Sec. 4 Twp. 21S Rge. (E) 21 (W)
 Location as "NE/CNW/SW" or footage from lines C NW/4 NE/4
 Lease Owner Skelly Oil Company
 Lease Name Marguerite Horyna Well No. 1
 Office Address Box 1650, Tulsa, Oklahoma
 Character of Well (completed as Oil, Gas or Dry Hole) Dry Hole
 Date well completed October 26, 19 62
 Application for plugging filed October 26, 19 62
 Application for plugging approved October 26, 19 62
 Plugging commenced October 26, 19 62
 Plugging completed October 26, 19 62
 Reason for abandonment of well or producing formation Dry Hole

If a producing well is abandoned, date of last production 19
 Was permission obtained from the Conservation Division or its agents before plugging was commenced? Yes (verbally)

Name of Conservation Agent who supervised plugging of this well Mr. Hugh Scott
 Producing formation _____ Depth to top _____ Bottom _____ Total Depth of Well 4490 Feet
 Show depth and thickness of all water, oil and gas formations.

OIL, GAS OR WATER RECORDS

CASING RECORD

FORMATION	CONTENT	FROM	TO	SIZE	PUT IN	PULLED OUT
Mississippi	Dry	4398'	4490'	8-5/8"	560'	None

Describe in detail the manner in which the well was plugged, indicating where the mud fluid was placed and the method or methods used in introducing it into the hole. If cement or other plugs were used, state the character of same and depth placed, from _____ feet to _____ feet for each plug set.

Mud	4490' to 555'
Hall. plug & hulls	555' to 550'
20 sacks cement	550' to 494'
Mud	494' to 60'
Hall. plug & hulls	60' to 55'
20 sacks cement	55' to 6'
Surface soil	6' to Surface

RECEIVED
 STATE CORPORATION COMMISSION

NOV 2 1962

CONSERVATION DIVISION
 Wichita, Kansas

11-2-62

(If additional description is necessary, use BACK of this sheet)

Name of Plugging Contractor Rains & Williamson Oil Company
 Address Wichita, Kansas

STATE OF Kansas, COUNTY OF Reno, ss.
D. E. Smith (employee of owner) or (SUPERVISOR) of the above-described well, being first duly sworn on oath, says: That I have knowledge of the facts, statements, and matters herein contained and the log of the above-described well as filed and that the same are true and correct. So help me God.

(Signature) D. E. Smith

1020 No. Main St., Hutchinson, Kansas
 (Address)

SUBSCRIBED AND SWORN TO before me this 1st day of November, 19 62

My commission expires April 7, 1963

Josephine L. Johnson
 Notary Public.

15.083.00042.00.00

ROTARY DRILLING LOG

Operator: Skelly Oil Company
No. 1 HORYNA
C NW NE of Sec. 4-21S-21W
Hodgeman County, Kansas

CONTRACTOR: Rains & Williamson Oil Co.
COMM: 10-10-62
COMP: 10-26-62

Remarks: Set 8-5/8" surface casing
at 560' w/400 sax Pozmin HA-5

Formations:

Surface Rock	40'
Shale and Shell	100'
Sand	220'
Shale and Sand	350'
Shale	485'
Shale and Shells	560'
Shale	1050'
Red Bed and Shale	1383'
Anhydrite	1415'
Shale and Red Bed	1545'
Shale and Shells	1960'
Shale	2205'
Line	2725'
Line and Shale Break	3330'
Line and Shale	3455'
Shale	3530'
Chalky Line and Shale	3665'
Line and Shale	3750'
Shale and Line	3765'
Line	4000'
Line and Shale Breaks	4040'
Line	4405'
Line and Chert	4410'
Chat and Line	4445'
Line	4490'
Rotary Total Depth (D&A)	4490'

RECEIVED
STATE CORPORATION COMMISSION

DEC 26 1962

CONSERVATION DIVISION
Wichita, Kansas


Subscribed and sworn to before me, a
Notary Public in and for the State of
Kansas, County of Sedgwick, this 29th
day of October, 1962.


Sandra Ames

My Commission Expires: August 14, 1966

We certify the above log is
true and correct to the best
of our knowledge and belief.

RAINS & WILLIAMSON OIL CO.

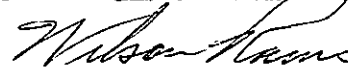
Wilson Rains
Partner