


STATE OF KANSAS  
STATE CORPORATION COMMISSION

Give All Information Completely  
Make Required Affidavit  
Mail or Deliver Report to:  
Conservation Division  
State Corporation Commission  
212 North Market, Insurance Bldg.  
Wichita, Kansas

15.083.00009.00.00  
WELL PLUGGING RECORD

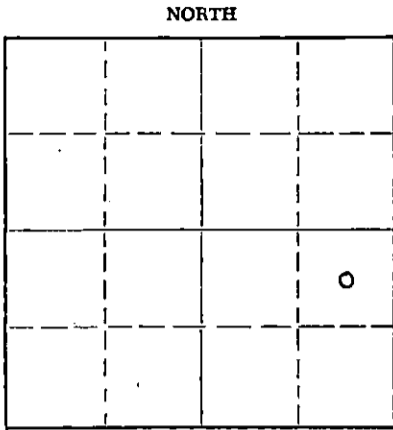

Locate well correctly on above Section Plat

Hodgeman County. Sec. 5 Twp. 21S Rge. 21 (E) W(W)  
Location as "NE/CNW%SW%" or footage from lines C NE SE  
Lease Owner Colorado Oil & Gas Corporation  
Lease Name Foreman Well No. 1  
Office Address Denver Club Building, Denver, Colorado  
Character of Well (completed as Oil, Gas or Dry Hole) Dry Hole  
Date well completed March 16, 1961  
Application for plugging filed March 16, 1961  
Application for plugging approved March 16, 1961  
Plugging commenced March 16, 1961  
Plugging completed March 16, 1961  
Reason for abandonment of well or producing formation Dry Hole

If a producing well is abandoned, date of last production 19  
Was permission obtained from the Conservation Division or its agents before plugging was commenced? Yes

Name of Conservation Agent who supervised plugging of this well ~~Mark Rivers~~ Frank Broadfoot.  
Producing formation \_\_\_\_\_ Depth to top \_\_\_\_\_ Bottom \_\_\_\_\_ Total Depth of Well 4421 Feet  
Show depth and thickness of all water, oil and gas formations.

OIL, GAS OR WATER RECORDS

CASING RECORD

FORMATION	CONTENT	FROM	TO	SIZE	PUT IN	PULLED OUT
		0	279'	8 5/8"	279'	None

Describe in detail the manner in which the well was plugged, indicating where the mud fluid was placed and the method or methods used in introducing it into the hole. If cement or other plugs were used, state the character of same and depth placed, from \_\_\_\_\_ feet to \_\_\_\_\_ feet for each plug set.

4421' to 240' - Heavy rotary mud  
240 to 179' - Plug 1/2 sackhulls & 20 sacks cement  
179 to 30' - Heavy rotary mud  
30 to 4' - Plug 1/2 sack hulls, 10 sacks cement  
4 to 0 - cellar

RECEIVED  
STATE CORPORATION COMMISSION

MAR 23 1961

CONSERVATION DIVISION  
Wichita, Kansas

3-28-61

(If additional description is necessary, use BACK of this sheet)  
Name of Plugging Contractor PEEL BROTHERS, INC.  
Address P. O. Box 359, Hoisington, Kansas

STATE OF KANSAS, COUNTY OF BARTON, ss.  
(employee of owner) or (owner/operator) of the above-described well, being first duly sworn on oath, says: That I have knowledge of the facts, statements, and matters herein contained and the log of the above-described well as filed and that the same are true and correct. So help me God. PEEL BROTHERS, INC.

(Signature) BY John Matlock  
P. O. Box 359 Hoisington, Kansas  
(Address)

SUBSCRIBED AND SWORN TO before me this 24 day of March, 1961

Ruth Grant  
Notary Public.

My commission expires April 27, 1964



15.083.00009.00.00

DRILLERS' LOG

Well Owner: Colorado Oil & Gas Corporation  
Well Name: Foreman Well No. 1  
Total Depth: 4421'  
Commenced: 2/28/61  
Completed: 3/16/61  
Casing: 8 5/8" @ 279' cem.

C NE SE  
Sec. 5, Twp. 21S, Rge. 21W  
County: Hodgeman,  
Kansas  
Elevation:

Contractor: Peel Brothers, Inc.

Production: Dry

Figures below indicate bottoms of formations:

Shale & post rock	0	45
Sand shale & shells		130
Shale		460
Shale & red bed		723
Anhydrite		736
Sand		995
Sand & shale		1035
Shale & shells		1375
Anhydrite		1393
Shale		1700
Shale & lime		2065
Lime		2445
Lime & shale		2555
Lime		3100
Lime & shale		3530
Lime		3605
Shale & chalk		3665
Lime		4350
Cherty lime		4360
Chert		4421
Total Depth		4421

RECEIVED  
STATE CORPORATION COMMISSION  
MAR 23 1961  
CONSERVATION DIVISION  
Wichita, Kansas

This is to certify that the above information is to the best of our knowledge, true and correct.

PEEL BROTHERS, INC.

BY Jac. Matthews

SUBSCRIBED AND SWORN to before me this 24 day of March, 1961

My commission expires: April 27, 1964

Lith Brant  
Notary Public