


15.083.21033.00.00

WELL PLUGGING RECORD

Give All Information Completely  
Make Required Affidavit

COUNTY Hodgeman SEC. 16 TWP. 21S RGE. 21 W  
Location as in quarters or footage from lines:  
1650' FSL, 1320' FEL SE/4

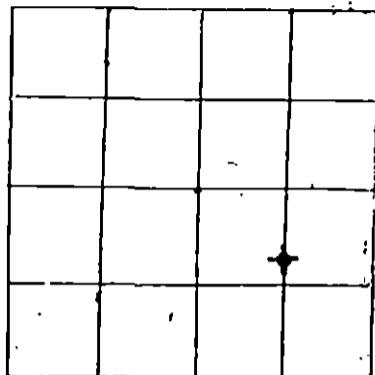

Locate Well  
correctly on above  
Section Plat.

Lease Owner PETRO-DYNAMICS CORP.  
Lease Name Young Well No. 1  
Office Address 555 N. Woodlawn, Bldg. 1 - Suite 207, Wichita, KS  
Character of Well (Completed as Oil, Gas or Dry Hole): Dry Hole  
Date Well Completed 1-7-83  
Application for plugging filed 1-7-83 verbally  
Plugging commenced 9:45 p.m. 1-7-83  
Plugging completed 11:15 p.m. 1-7-83  
Reason for abandonment of well or producing formation Dry Hole

Was permission obtained from the Conservation Division or it's  
Agent's before plugging was commenced? yes

Name of Conservation Agent who supervised plugging of this well Bob Tarbuddon, Dodge City  
Producing formation N/A Depth to top N/A bottom N/A T.D. N/A

Show depth and thickness of all water, oil and gas formations.

OIL, GAS OR WATER RECORDS

Casing Record

Formation	Content	From	To	Size	Put in	Pulled Out
				8 5/8"	1289' GL	NONE

Describe in detail the manner in which the well was plugged, indicating where the mud  
fluid was placed and the method or methods used in introducing it into the hold. If cement  
or other plugs were used, state the character of same and depth placed, from          feet  
to          feet for each plug set. Plugged with 120 sacks 50-50 pozmix, 4% gel, 3% CaCl

Set 1st plug @ 1320' with 70 sacks  
Set 2nd plug @ 660' with 25 sacks  
Set 3rd plug @ 40' with 10 sacks w/solid bridge plug  
15 sacks rathole

1-19-83

RECEIVED  
STATE CORPORATION COMMISSION  
16510

JAN 19 1983

(If additional description is necessary, use BACK of this sheet)  
Name of Plugging Contractor Sun Oilwell Cementing CONSERVATION DIVISION  
Wichita, Kansas

STATE OF Kansas COUNTY OF Sedgwick, ss.  
C. K. Morrison (employee of owner) or (~~owner or operator~~) of the  
above-described well, being first duly sworn on oath, says: That I have knowledge of the  
facts, statements, and matters herein contained and the log of the above-described well as  
filed and that the same are true and correct. So help me God.

(Signature) [Signature]  
555 N. Woodlawn, Bldg. 1 - Suite 207  
Wichita, KS (Address) 67208

SUBSCRIBED AND SWORN TO before me this 14th day of January, 19 83

Rebecca J. Schneider  
Rebecca J. Schneider Notary Public.

My Commission expires: July 1, 1986

