


15.083.20922.00.00

WELL PLUGGING RECORD

Give All Information Completely
 Make Required Affidavit

COUNTY Hodgeman SEC. 23 TWP. 21S RGE. 21W ~~RAK~~
 Location as in quarters or footage from lines:
C SW SE

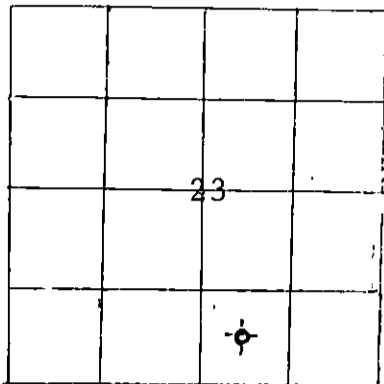

Locate Well
 correctly on above
 Section Platt.

Lease Owner American Energies Corporation
 Lease Name Barnes Well No. 1
 Office Address 575 Fourth Financial Center, Wichita, KS 67202
 Character of Well (Completed as Oil, Gas or Dry Hole): Dry Hole
 Date Well Completed January 5, 1982
 Application for plugging filed January 5, 1982
 Plugging commenced January 4, 1982
 Plugging completed January 5, 1982
 Reason for abandonment of well or producing formation _____

Was permission obtained from the Conservation Division or it's
 Agent's before plugging was commenced? yes

Name of Conservation Agent who supervised plugging of this well Steve Durrant

Producing formation _____ Depth to top _____ bottom _____ T.D. 4357

Show depth and thickness of all water, oil and gas formations.

OIL, GAS OR WATER RECORDS

Casing Record

Formation	Content	From	To	Size	Put in	Pulled Out
Surface	shale	0	1053	8-5/8"	1052'	none
	cemented w/250 sx	60/40	posmix,	2%gel, 3%cc.	200 sx	
	common, plug down	at 9:30	a.m.	2-30-81 by	Sun;	
	cement did circ.					

Describe in detail the manner in which the well was plugged, indicating where the mud
 fluid was placed and the method or methods used in introducing it into the hold. If cement
 or other plugs were used, state the character of same and depth placed, from _____ feet
 to _____ feet for each plug set.

Plugged w/125 sx 50/50 posmix 4%gel, 3%cc
70 sx at 1020'
40 sx @ 540'
10 sx @ 40'
5 sx in rat hole; Job completed at 1:15 a.m. 1-5-82 by Sun.

(If additional description is necessary, use BACK of this sheet)

Name of Plugging Contractor Husky Drilling Co., Inc.

STATE OF KANSAS COUNTY OF SEDGWICK, ss.

Jon T. Williams, Jr. (employee of owner) or (owner or operator) of the
 above-described well, being first duly sworn on oath, says: That I have knowledge of the
 facts, statements, and matters herein contained and the log of the above-described well as
 filed and that the same are true and correct. So help me God.

(Signature) [Signature]
HUSKY DRILLING CO., INC.
200 E. First, Suite 500, Wichita, KS
 (Address) 67202

SUBSCRIBED AND SWORN TO before me this 5th day of January, 19 82



Geraldine Stewart
 Notary Public

My Commission expires February 14, 1985

JAN 11 1982 1-11-82