


15.083-10184.00.00

WELL PLUGGING RECORD

Give All Information Completely
Make Required Affidavit
Mail or Deliver Report to:
Conservation Division
State Corporation Commission
211 No. Broadway
Wichita, Kansas

NORTH

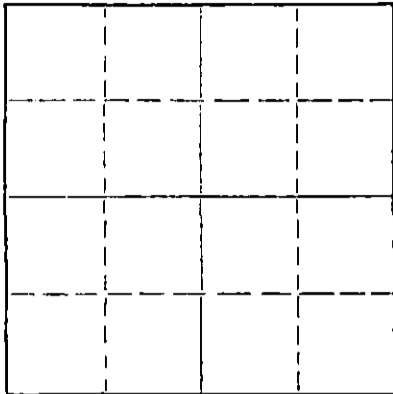

Locate well correctly on above
Section Plat

Hodgeman County, Sec. 26 Twp. 21 Rge. (E) 21 (W)
Location as "NE/CNW/SW" or footage from lines C NW NE
Lease Owner Pickrell Drilling Company
Lease Name Eakin Well No. 1
Office Address 705 4th National Bank Building, Wichita, Kansas
Character of Well (completed as Oil, Gas or Dry Hole) Dry Hole
Date well completed October 27, 1964
Application for plugging filed October 27, 1964
Application for plugging approved October 27, 1964
Plugging commenced October 27, 1964
Plugging completed October 27, 1964
Reason for abandonment of well or producing formation Dry Hole

If a producing well is abandoned, date of last production 19
Was permission obtained from the Conservation Division or its agents before plugging was commenced? Yes

Name of Conservation Agent who supervised plugging of this well Hugh E. Scott
Producing formation Depth to top Bottom Total Depth of Well 4365 Feet
Show depth and thickness of all water, oil and gas formations.

OIL, GAS OR WATER RECORDS

CASING RECORD

FORMATION	CONTENT	FROM	TO	SIZE	PUT IN	PULLED OUT
				8 5/8"	1260'	None

Describe in detail the manner in which the well was plugged, indicating where the mud fluid was placed and the method or methods used in introducing it into the hole. If cement or other plugs were used, state the character of same and depth placed, from feet to feet for each plug set.

Heavy mud to 700'. Set plug. Cemented with
35 sacks cement. Heavy mud to 35'. Set plug.
Cemented with 15 sacks cement to bottom of
cellar. Plugged rat hole with 2 sacks cement.

RECEIVED
STATE CORPORATION COMMISSION

NOV 5 1964

CONSERVATION DIVISION
Wichita, Kansas

(If additional description is necessary, use BACK of this sheet)
Name of Plugging Contractor Pickrell Drilling Company
Address 705 4th National Bank Building, Wichita 2, Kansas

STATE OF KANSAS, COUNTY OF SEDGWICK, ss.
C. W. Sebitts


(~~owner or operator~~) of the above-described well, being first duly sworn on oath, says: That I have knowledge of the facts, statements, and matters herein contained and the log of the above-described well as filed and that the same are true and correct. So help me God

(Signature) C. W. Sebitts
705 4th National Bank Building, Wichita, Ks.
(Address)

Subscribed and Sworn to before me this 3rd day of November, 1964

Maxine Blackman
Maxine Blackman, Notary Public.

My commission expires June 21, 1966

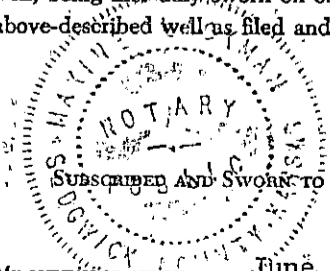

15.083.10184.00.00
ROTARY DRILLING LOG

COMPANY: PICKRELL DRILLING COMPANY
705 4th National Bank Bldg.
Wichita, Kansas

Rotary Drilling Commenced 10-16-64

Rotary Drilling Completed 10-26-64

LOCATION: EAKIN No. 1, C NW NE Section 26-21-21W, Hodgeman County, Kansas.

CONTRACTOR: **PICKRELL DRILLING COMPANY**
Wichita, Kansas

CASING RECORD: (32 jts) 8 5/8" surface casing set at 1259' cemented with 600 sacks cement. Circulated. Completed 7:15 P.M. October 17, 1964. No oil string run, D & A.

LOG

(Figures indicate bottom of formation — measurements from top of rotary bushing.)

40	Soil & Clay	<u>C. F. S.</u>
80	Sand	4300
160	Shale	4305
200	Shale & Sand	4310
605	Shells, Shale & Red Beds	
700	Red Beds & Shale	
880	Sand	
1252	Shale & Shells	<u>Slope Test</u>
1290	Anhydrite	2500
1685	Shale & Shells	3000
2030	Shale, Shells & Lime	3500
2365	Lime & Shale	3950
2700	Lime	
3483	Lime & Shale	
4250	Lime	<u>S. L. M.</u>
4305	Lime & Shale	3611
4365	Mississippi & RTD	3905
		4227

RECEIVED
STATE CORPORATION COMMISSION

NOV 5 1964

CONSERVATION DIVISION
Wichita, Kansas

The undersigned, C. W. Sebitts, Attorney-in-Fact for PICKRELL DRILLING COMPANY, hereby certifies in behalf of said Company, that the above is a true and correct log of the formation encountered in drilling the above well as reflected by the Daily Drilling Reports.

PICKRELL DRILLING COMPANY

By C. W. Sebitts Attorney-in-Fact

STATE OF KANSAS }
COUNTY OF SEDGWICK } ss.:

On this 3rd day of November, 1964, before me the undersigned, a Notary Public, in and for the County and State aforesaid, personally appeared C. W. Sebitts, to me known to be the identical person who subscribed the name of PICKRELL DRILLING COMPANY to the foregoing instrument as its Attorney-in-Fact and acknowledged to me that he executed the same as his free and voluntary act and deed, and as the free and voluntary act and deed of such company, for the uses and purposes therein set forth.

Given under my hand and seal of office the day and year last above written.

My commission expires: June 21, 1966.

Maxine Blackman
Maxine Blackman, Notary Public