

Give All Information Completely
Make Required Affidavit
Mail or Deliver Report to:
Conservation Division
State Corporation Commission
211 No. Broadway
Wichita, Kansas

WELL PLUGGING RECORD

Hodgeman County, Sec. 28 Twp. 21S Rge. 21 (W)

Location as "NE/CNW/SW" or footage from lines C SW SW

Lease Owner Rains & Williamson Oil Co.

Lease Name BACON Well No. 1

Office Address 412 Union Center - Wichita 2, Kansas

Character of Well (completed as Oil, Gas or Dry Hole) Dry Hole

Date well completed 3-6 19 63

Application for plugging filed 3-5 19 63

Application for plugging approved 3-5 19 63


Plugging commenced 3-5 19 63

Plugging completed 3-6 19 63

Reason for abandonment of well or producing formation No oil or gas found in commercial quantities.

If a producing well is abandoned, date of last production ----- 19--

Was permission obtained from the Conservation Division or its agents before plugging was commenced? Yes

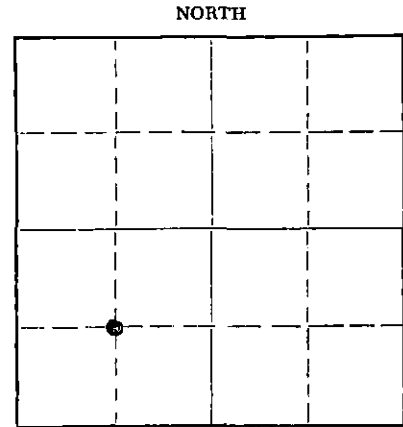

Locate well correctly on above Section Plat

Name of Conservation Agent who supervised plugging of this well Hugh Scott, Sublette, Kansas

Producing formation None Depth to top --- Bottom --- Total Depth of Well 4456 Feet

Show depth and thickness of all water, oil and gas formations.

OIL, GAS OR WATER RECORDS

CASING RECORD

FORMATION	CONTENT	FROM	TO	SIZE	PUT IN	PULLED OUT
				8-5/8"	282'	NONE

Describe in detail the manner in which the well was plugged, indicating where the mud fluid was placed and the method or methods used in introducing it into the hole. If cement or other plugs were used, state the character of same and depth placed, from _____ feet to _____ feet for each plug set.

Set first plug at 540 feet and cemented through drill pipe with 20 sacks cement. Filled hole with rotary mud to 280 feet. At 280 feet set second plug. Cemented through drill pipe with 20 sacks cement. Filled hole to 40 feet of base of cellar with rotary mud. Capped with 15 sacks cement.

RECEIVED
STATE CORPORATION COMMISSION

MAR 11 1963

CONSERVATION DIVISION
Wichita, Kansas

(If additional description is necessary, use BACK of this sheet)

Name of Plugging Contractor Rains & Williamson Oil Co.

Address 412 Union Center Building - Wichita 2, Kansas

STATE OF KANSAS, COUNTY OF SEDGWICK, ss.

Wilson Rains - Partner (owner or operator) of the above-described well, being first duly sworn on oath, says: That I have knowledge of the facts, statements, and matters herein contained and the log of the above-described well as filed and that the same are true and correct. So help me God.

(Signature) Wilson Rains Wilson Rains

412 Union Center - Wichita 2, Kansas (Address)

SUBSCRIBED AND SWORN TO before me this 8th day of March, 19 63

My commission expires November 8, 1966

Sherry Gish Notary Public.

15.083.10226.00.00
ROTARY DRILLING LOG

Operator: Rains & Williamson Oil Co.
NO. 1 BACON
C SW SW Sec. 28-21S-21W
Hodgeman County, Kansas

Contractor: Rains & Williamson
Oil Co.
Commenced: 2-22-63
Completed: 3-6-63

Remarks: Set 8-5/8" surface casing at 282' with 135 sacks quick cement

FORMATIONS

Cellar	4'
Shale and Shells	110'
Shale with Sand Streaks	130'
Shale and Shells	220'
Sand	227'
Shale	530'
Red Beds and Shale	605'
Shale	674'
Anhydrite (False)	689'
Shale	775'
Sand	960'
Red Beds and Shale	1325'
Anhydrite	1352'
Shale and Shells	2050'
Lime and Shale	2235'
Lime	2505'
Shale and Lime	2700'
Lime and Shale	2873'
Shale and Lime	3530'
Lime and Shale	3600'
Shale, Lime and Chalk	3695'
Shale and Lime	3785'
Kansas City Lime	3837'
Lime	4456'

Rotary Total Depth (D & A) 4456'


RECEIVED
STATE CORPORATION COMMISSION
MAR 11 1963
CONSERVATION DIVISION
TOPEKA, KANSAS

We certify the above log is true and correct to the best of our knowledge and belief.

RAINS & WILLIAMSON OIL CO.


Wilson Rains
Partner

Subscribed and sworn to before me, a Notary Public in and for the State of Kansas, County of Sedgwick, this 8th day of March, 1963.

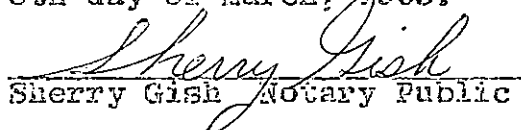
Sherry Gish Notary Public

My Commission Expires:
November 8, 1966