


STATE OF KANSAS
STATE CORPORATION COMMISSION

4-15-083.10346.00.00
WELL PLUGGING RECORD

Give All Information Completely
Make Required Affidavit
Mail or Deliver Report to:
Conservation Division
State Corporation Commission
211 No. Broadway
Wichita, Kansas

NORTH

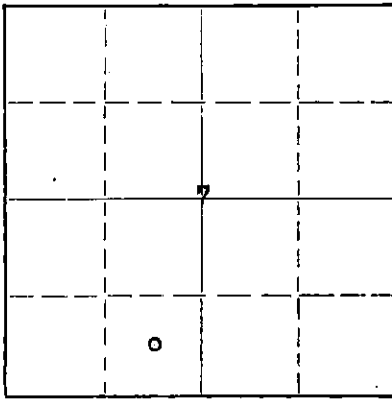

Locate well correctly on above
Section Plat

Hodgeman County. Sec. 7 Twp. 21S Rge. (E) 22 (W)
Location as "NE/CNW%SW%" or footage from lines C. SE SW
Lease Owner Wilcox Oil Company
Lease Name Bamberger Well No. 1
Office Address Box 1440 Tulsa, Oklahoma
Character of Well (completed as Oil, Gas or Dry Hole) Dry hole
Date well completed September 14, 19 60
Application for plugging filed August 15, 19 63
Application for plugging approved _____ 19 _____
Plugging commenced September 14 19 60
Plugging completed September 14 19 60
Reason for abandonment of well or producing formation Dry hole

If a producing well is abandoned, date of last production _____ 19 _____
Was permission obtained from the Conservation Division or its agents before plugging was commenced? Yes

Name of Conservation Agent who supervised plugging of this well M. A. Rives
Producing formation _____ Depth to top _____ Bottom _____ Total Depth of Well 4570 Feet
Show depth and thickness of all water, oil and gas formations.

OIL, GAS OR WATER RECORDS

CASING RECORD

FORMATION	CONTENT	FROM	TO	SIZE	PUT IN	PULLED OUT
				8-5/8"	288'	None

Describe in detail the manner in which the well was plugged, indicating where the mud fluid was placed and the method or methods used in introducing it into the hole. If cement or other plugs were used, state the character of same and depth placed, from _____ feet to _____ feet for each plug set.

Filled hole with heavy rotary mud. Placed 20 sacks cement plug from 290' to 35'.
Ran 10 sacks of cement in top of surface casing.

RECEIVED
STATE CORPORATION COMMISSION

AUG 19 1963

CONSERVATION DIVISION
Wichita, Kansas

8-19-63

(If additional description is necessary, use BACK of this sheet)

Name of Plugging Contractor Strata Drilling Inc.
Address Box 355, Great Bend, Kansas

STATE OF Oklahoma, COUNTY OF Tulsa, ss.
Steve H. Helm (employee of owner) or ~~(owner or operator)~~ of the above-described well, being first duly sworn on oath, says: That I have knowledge of the facts, statements, and matters herein contained and the log of the above-described well as filed and that the same are true and correct. So help me God.

(Signature) Steve H. Helm
Box 1440, Tulsa, Oklahoma
(Address)

SUBSCRIBED AND SWORN TO before me this 15 day of August, 19 63
Clara Alworth
Notary Public.

My commission expires 8-31-63



15.083 403 6.00.00
DRILLERS LOG

#1 Bamberger

CASING RECORD:
 288.75' 8-5/8"
 surface casing

COMPANY: Wilcox Oil Company
 CONTRACTOR: Strata Drilling, Inc.

DESCRIPTION: SE SW
 Section 7-21S-22W
 Hodgeman Co., Kansas

TOTAL DEPTH:
 4570'

COMMENCED: September 2, 1960
 COMPLETED: September 14, 1960

ELEVATION: 2261' GR

D. & A.

<u>FORMATION</u>	<u>FROM</u>	<u>TO</u>	<u>REMARKS</u>
Surface Soil	0	298	Ran 288.75' 8-5/8" surface casing; set and cemented at 296' with 225 sacks of HA-5. Plug down at 4:30 A. M. 9-3-1960. Cement circ.
Clay & Shale	298	825	
Anhydrite	825	840	
Shale	840	905	
Sand	905	1100	
Shale	1100	1464	
Anhydrite	1464	1480	
Shale & Shells	1480	1975	
Shale & Lime	1975	3439	
Lime	3439	4373	
Lime & Shale	4373	4442	
Chert & Lime	4442	4570	

Total Depth 4570'

RECEIVED
 STATE CORPORATION COMMISSION

AUG 19 1960

CONSERVATION DIVISION
 Wichita, Kansas

Ran Schlumberger Log.

D. & A.

Plugged @ 2:00 P. M. 9-14-1960

STATE OF KANSAS)
) ss.
 COUNTY OF BARTON)

I certify that this is a true and correct copy of the above log to the best of my knowledge.

STRATA DRILLING, INC.

Jim B. McWilliams
 Jim B. McWilliams, Secy-Treas.

Subscribed and sworn to before me this 16th day of September, 1960.

Elaine H. Taylor
 Elaine H. Taylor, Notary Public

My Commission Expires:

December 14, 1961