

WELL PLUGGING RECORD

Give All Information Completely
Make Required Affidavit
Mail or Deliver Report to:
Conservation Division
State Corporation Commission
800 Bittling Building
Wichita, Kansas

~~Seward~~ Seward County, Sec. 9 Twp. 21 Rge. 22 (E) (W)

Location as "NE/CNW/SW" or footage from lines C SW NW

Lease Owner Colorado Oil & Gas Corporation

Lease Name Cox Well No. 1

Office Address P.O. Box 999, Liberal, Kansas

Character of Well (completed as Oil, Gas or Dry Hole) Dry Hole

Date well completed 9-24-59 19__

Application for plugging filed No, verbale, attached 19__

Application for plugging approved Verbale 9-24-59 19__


Plugging commenced 11 AM 9-25-59 19__

Plugging completed 1 PM 9-25-59 19__

Reason for abandonment of well or producing formation no commercial production found

If a producing well is abandoned, date of last production 19__

Was permission obtained from the Conservation Division or its agents before plugging was commenced? Yes

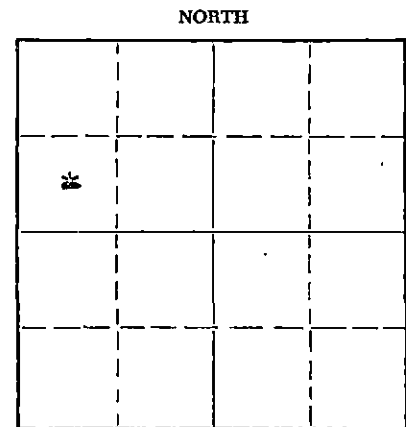

Locate well correctly on above Section Plat

Name of Conservation Agent who supervised plugging of this well M.A. Rives

Producing formation None Depth to top 4510 Bottom _____ Total Depth of Well 4510 Feet

Show depth and thickness of all water, oil and gas formations.

OIL, GAS OR WATER RECORDS

CASING RECORD

FORMATION	CONTENT	FROM	TO	SIZE	PUT IN	PULLED OUT
Surface sand	water	-	269	8 5/8"	340'	None

Describe in detail the manner in which the well was plugged, indicating where the mud fluid was placed and the method or methods used in introducing it into the hole. If cement or other plugs were used, state the character of same and depth placed, from _____ feet to _____ feet for each plug set.

50 sx cement in bottom to 4389, filled hole with heavy mud, settled to 340', plug set at 340' with 20 sx cement on top, mud to 30', plug set at 30' cemented to bottom of cellar.

RECEIVED
STATE CORPORATION COMMISSION

SEP 29 1959

CONSERVATION DIVISION
WICHITA, KANSAS

9-29-59

(If additional description is necessary, use BACK of this sheet)

Name of Plugging Contractor Pickerill Drilling Co., Wichita, Kansas

Address _____

STATE OF Kansas, COUNTY OF Seward, ss.

A. J. Ziser (employee of owner) or (~~owner or operator~~) of the above-described

well, being first duly sworn on oath, says: That I have knowledge of the facts, statements, and matters herein contained and the log of the above-described well as filed and that the same are true and correct. So help me God.

(Signature) [Signature]

Box 999 Liberal Ks. (Address)

SUBSCRIBED AND SWORN to before me this 25th day of September, 19 59

William B. Claunch
Notary Public.

My commission expires 11-1-62

