


Give All Information Completely
Make Required Affidavit
Mail or Deliver Report to:
Conservation Division
State Corporation Commission
211 No. Broadway
Wichita, Kansas

WELL PLUGGING RECORD

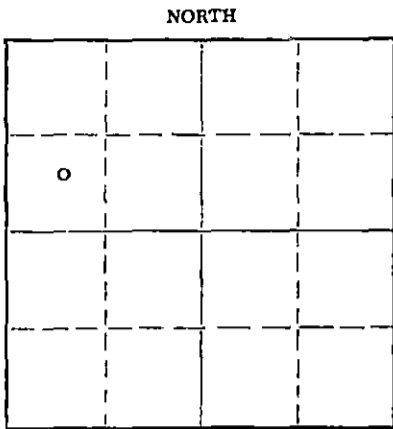

Locate well correctly on above Section Plat

Hodgeman County, Sec. 16 Twp. 21S Rge. 22W (E) (W)
Location as "NE/CNW/SW" or footage from lines c SW NW
Lease Owner PetroCap & Bud Spradlin
Lease Name Wieland Well No. 1-B
Office Address 312 Union Center, Wichita, Kansas 67202
Character of Well (completed as Oil, Gas or Dry Hole) Dry Hole
Date well completed November 5 19 64
Application for plugging filed November 5 19 64
Application for plugging approved November 5 19 64
Plugging commenced November 5 19 64
Plugging completed November 5 19 64
Reason for abandonment of well or producing formation Dry Hole

If a producing well is abandoned, date of last production 19
Was permission obtained from the Conservation Division or its agents before plugging was commenced? Yes

Name of Conservation Agent who supervised plugging of this well Hugh E. Scott, SUBLETTE, Kansas
Producing formation Depth to top Bottom Total Depth of Well Feet
Show depth and thickness of all water, oil and gas formations.

OIL, GAS OR WATER RECORDS

CASING RECORD

FORMATION	CONTENT	FROM	TO	SIZE	PUT IN	PULLED OUT
		0	283'	8 5/8"	283'	None

Describe in detail the manner in which the well was plugged, indicating where the mud fluid was placed and the method or methods used in introducing it into the hole. If cement or other plugs were used, state the character of same and depth placed, from feet to feet for each plug set.

Set Plug @ 200'/25 sacks cement
275'/25 sacks cement
40'/10 sacks cement

RECEIVED
STATE CORPORATION COMMISSION

NOV 16 1964

CONSERVATION DIVISION
Wichita, Kansas

11-16-64

(If additional description is necessary, use BACK of this sheet)
Name of Plugging Contractor Hellar Drilling Company, Inc.
Address 1014 Union Center, Wichita, Kansas 67202

STATE OF Kansas, COUNTY OF Sedgwick, ss.
D. L. Hellar, Pres. of Hellar Drilg. Co. Inc. (employee of owner) or (owner or operator) of the above-described well, being first duly sworn on oath, says: That I have knowledge of the facts, statements, and matters herein contained and the log of the above-described well as filed and that the same are true and correct. So help me God.
(Signature) D. L. Hellar D. L. Hellar, Pres.
1014 Union Center, Wichita, Kansas 67202
(Address)

SUBSCRIBED AND SWORN TO before me this 13th day of November, 19 64

My commission expires March 25, 1968. Catherine Darcey Notary Public.

15.083.10319.00.00

DRILLER'S LOG

COMPANY: PetroCap & Bud Spradlin
 CONTRACTOR: Hellar Drilling Company, Inc.
 LEASE: #1-B Wieland
 LOCATION: c SW NW 16-21S-22W, Hodgeman County, Kansas
 COMMENCED: October 25, 1964
 COMPLETED: November 5, 1964
 CASING: Set 8 5/8" surface casing @ 283'/200 sacks cement

0-284	Shale & Shells
284-425	Clay & Shale
425-797	Shale & Red Bed
797-811	Anhydrite
811-1427	Red Bed, Shale
1427-1460	Anhydrite
1460-1475	Shale
1475-1935	Shale & Red Bed
1935-2493	Salt Section
2493-3022	Lime & Shale
3022-3206	Shale w/lime streaks
3206-3375	Shale & Lime
3375-3907	Lime & Shale
3907-3957	Lsg. K.C. lime
3957-4056	K.C. lime
4056-4130	Lime
4130-4184	Shale & Lime
4184-4350	Lime & Shale
4350-4359	Lime
4359-4405	Lime & Dolomite
4405	Rotary Total Depth
	Dry & Abandoned

STATE OF KANSAS
 NOV 16 1964
 CONSERVATION DIVISION
 Wichita, Kansas

STATE OF KANSAS)
) SS
 COUNTY OF SEDGWICK)

I, D. L. Hellar, do hereby certify that the above and foregoing is a true and correct copy of the log of the #1-B Wieland, c SW NW 16-21S-22W, Hodgeman County, Kansas, as reflected by the files of the Hellar Drilling Company, Inc.

HELLAR DRILLING COMPANY, INC.

By D. L. Hellar
 President - D. L. Hellar

Subscribed and sworn to before me, a Notary Public, in and for Sedgwick County, Kansas, this 13th day of November, 1964.

Catherine Darcey
 Notary Public - Catherine Darcey

My Commission Expires:
 March 25, 1968.