


Give All Information Completely  
Make Required Affidavit  
Mail or Deliver Report to:  
Conservation Division  
State Corporation Commission  
211 No. Broadway  
Wichita, Kansas

WELL PLUGGING RECORD

NORTH

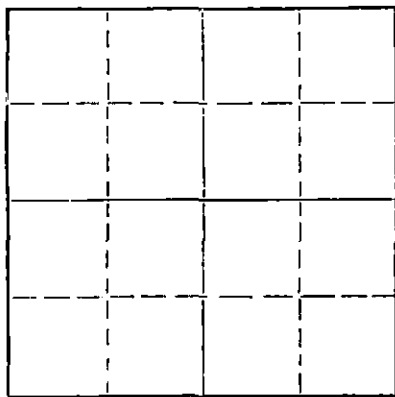

Locate well correctly on above  
Section Plat

Hodgeman County, Sec. 23 Twp. 21S Rge. 22W (E) (W)

Location as "NE/CNW/SW" or footage from lines C NW SE  
Lease Owner Imperial Oil Company  
Lease Name GILBERT Well No. 1  
Office Address 780 Fourth National Bldg., Wichita, Ks.  
Character of Well (completed as Oil, Gas or Dry Hole) Dry Hole  
Date well completed 12-7-63 19  
Application for plugging filed 12-7-63 19  
Application for plugging approved 12-7-63 19  
Plugging commenced 12-7-63 19  
Plugging completed 12-7-63 19  
Reason for abandonment of well or producing formation No Commercial quantities of oil found.  
If a producing well is abandoned, date of last production - - - 19  
Was permission obtained from the Conservation Division or its agents before plugging was commenced? Yes

Name of Conservation Agent who supervised plugging of this well Hugh Scott  
Producing formation - - - Depth to top - - - Bottom - - - Total Depth of Well 4501 Feet  
Show depth and thickness of all water, oil and gas formations.

OIL, GAS OR WATER RECORDS

CASING RECORD

FORMATION	CONTENT	FROM	TO	SIZE	PUT IN	PULLED OUT
	Surface Casing :			8-5/8"	277'	Not pulled

Describe in detail the manner in which the well was plugged, indicating where the mud fluid was placed and the method or methods used in introducing it into the hole. If cement or other plugs were used, state the character of same and depth placed, from \_\_\_\_\_ feet to \_\_\_\_\_ feet for each plug set.

Set first plug at 550 ft. with 20 sacks cement;

Set second plug at 260 ft with 20 sacks cement;

Set top plug at 40 ft. with 10 sacks cement.

RECEIVED  
STATE CORPORATION COMMISSION

JAN 16 1964

CONSERVATION DIVISION  
Wichita, Kansas

1-16-64

(If additional description is necessary, use BACK of this sheet)

Name of Plugging Contractor Imperial Oil of Kansas, Inc.  
Address Box 97, WaKeeney, Kansas

STATE OF KANSAS, COUNTY OF SEDGWICK, ss.

Raymond R. Dombaugh (employee of owner) or (owner) of the above-described well, being first duly sworn on oath, says: That I have knowledge of the facts, statements, and matters herein contained and the log of the above-described well as filed and that the same are true and correct. So help me God.

(Signature) Raymond R. Dombaugh  
780 Fourth National Bldg., Wichita, Ks.  
(Address)

SUBSCRIBED AND SWORN to before me this 13th day of January, 19 64

My commission expires July 5, 1966

Bette J. Silcott  
Bette J. Silcott Notary Public.

15.083.00239.00.00

DRILLER'S LOG

Imperial Oil Company  
780 Fourth National Bldg.  
Wichita, Kansas

GILBERT NO. 1  
C NW SE, Sec.23-21S-22W  
Hodgeman County, Kansas

**RECEIVED**  
STATE CORPORATION COMMISSION

JAN 16 1964

CONSERVATION DIVISION  
Wichita, Kansas

Elevation: 2266 KB  
Total Depth: 4501 ft.  
Production: Dry  
Commenced: 11-23-63  
Contractor: Imperial Oil of Kansas, Inc.  
Wichita 2, Kansas

Casing Record: Set 8-5/8" surface pipe at 275' with 200 sacks cement.

Figures indicate bottom of formation:

TOPS:

Surface 68'  
Shale & Sand 1434'  
Anhydrite 1471'  
Shale-Red Bed 1700'  
Shale-Shells 2200'  
Lime & Shale 4064'  
Lime 4445'  
Lime & Chert 4486'  
Chert 4501'

Top Anhydrite 1442 (# 824)  
Base Anhydrite 1471 (# 795)  
Heebner 3794 (-1528)  
Toronto 3808 (-1542)  
Douglas Lime 3850 (-1584)  
Lansing 3872 (-1606)  
Base Kansas City 4183 (-1917)  
Marmaton Lime 4191 (-1925)  
Cherokee Shale 4360 (-2094)  
Conglomerate 4420 (-2154)  
Mississippian  
(Osage) 4461 (-2195)  
R.T.D. 4501

We hereby certify this to be a correct and accurate log of the above described well, as shown on the daily drilling reports.

IMPERIAL OIL COMPANY

*Raymond R. Dombaugh*  
Raymond R. Dombaugh

Subscribed and sworn to before me this 13th day of January, 1964.

My commission expires:

July 5, 1966

*Bette J. Silcott*  
Bette J. Silcott, Notary Public