

STATE OF KANSAS  
STATE CORPORATION COMMISSION

15.083.20649.00.00  
WELL PLUGGING RECORD

Give All Information Completely  
Make Required Affidavit  
Mail or Deliver Report to  
Conservation Division  
State Corporation Comm.  
245 North Water  
Wichita, KS 67202

Hodgeman County, Sec. 20 Twp. 21S Rge. 22W E/W-  
Location as "NE/CNW $\frac{1}{2}$ SW $\frac{1}{2}$ " or footage from lines  
C-SE SE

Lease Owner Jan Oil Company (Atlas Oil & Gas CO.)  
Lease Name Five Star Farm Well No. 1  
Office Address P. O. Box 95226, OK City, OK 73143  
Character of Well (Completed as Oil, Gas or Dry Hole)


Dry Hole

Date Well completed May 5, 1979  
Application for plugging filed Verbal Application 19  
Application for plugging approved Verbal Approval 19  
Plugging commenced May 5, 1979  
Plugging completed May 5, 1979  
Reason for abandonment of well or producing formation

If a producing well is abandoned, date of last production 19

Was permission obtained from the Conservation Division or its agents before plugging was commenced? Yes

Name of Conservation Agent who supervised plugging of this well Marvin Schmidt  
Producing formation Depth to top Bottom Total Depth of Well 4,525'  
Show depth and thickness of all water, oil and gas formations.

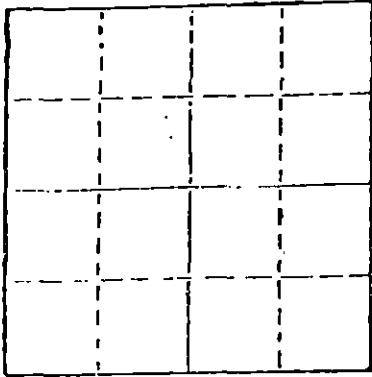

Locate well correctly on above Section Plot

OIL, GAS OR WATER RECORDS

CASING RECORD

FORMATION	CONTENT	FROM	TO	SIZE	PUT IN	PULLED OUT
				8-5/8"	360'	None

Describe in detail the manner in which the well was plugged, indicating where the mud fluid was placed and the method or methods used in introducing it into the hold. If cement or other plugs were used, state the character of same and depth placed, from feet to feet for each plug set.

Filled hole with heavy rotary mud from 4,525 ft. (rotary total depth) to 550 ft. Set plug at 550 ft. and cemented with 70 sacks cement. Filled hole with heavy rotary mud from 550 ft. to 300 ft. Set plug at 300 ft. and cemented with 20 sacks cement. Filled hole with heavy rotary mud from 300 ft. to 40 ft. Set solid plug at 40 ft. and cemented to cellar with 10 sacks cement, 3 sacks cement in rat hole.

Plugging operations accomplished utilizing Sun Oil Well cementing pump truck through 4 1/2 inch drill pipe.

(If additional description is necessary, use BACK of this sheet)

Name of Plugging Contractor Sun Oilwell Cementing, Inc.  
Box 169, Great Bend, Kansas 67530

RECEIVED  
MAY 14 1979  
STATE CORPORATION COMMISSION  
CONSERVATION DIVISION  
Wichita, Kansas

STATE OF Kansas COUNTY OF Sedgwick, ss.  
Dean Britting, Agent

of the above-described well, being first duly sworn on oath, says: That I have knowledge of the facts, statements, and matters herein contained and the log of the above-described well as filed and that the same are true and correct. So help me God.

(Signature) Dean Britting  
200 N. Main, Wichita, Kansas 67202  
(Address)

SUBSCRIBED AND SWORN TO before me this 11th day of May, 1979

Elsie Willison  
Notary Public.

My commission expires July 25, 1982

KANSAS DRILLERS LOG

COMPANY Jan Oil Company (Atlas Oil & Gas Co.)

SEC. 20 T. 21S. 22W

LOC. C-SE SE

FARM Five Star Farm No. 1

COUNTY Hodgeman

ROTARY TOTAL DEPTH 4,525'

COMM. April 25, 1979

COMP. May 5, 1979

CONTRACTOR H-30, Inc. (Rig #2)

ISSUED May 11, 1979

CASING

10 3/4"

8 5/8" Set at 554' cemented w/360 sxs cement

5 1/2"

4 1/2"

ELEVATION 2,303'K.B.

FIGURES INDICATE BOTTOM OF FORMATIONS

Sand	28'
Sand and Shale	450'
Shale	558'
Shale and Red Bed	950'
Sand	1,100'
Sand and Shale	1,900'
Shale	2,216'
Shale and Lime	2,270'
Lime and Shale	2,598'
Shale and Lime	2,725'
Lime and Shale	3,015'
Shale	3,155'
Lime and Shale	3,996'
Lime	4,525'
Rotary Total Depth	4,525'

I hereby certify the above and foregoing to be a true and correct log of the above described well as shown by the drilling reports.

H-30, INC.


*Dean Britting*  
Dean Britting

State of Kansas }  
County of Sedgwick } ss:

Subscribed and Sworn to before me a Notary Public  
in and for said county and state this 11th day of May, 1979.

RECEIVED  
STATE OF KANSAS  
CONSERVATION DIVISION

Wichita, Kansas

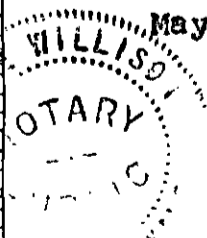

*Elsie Willison*  
Elsie Willison - Notary Public

My Commission Expires:

July 25, 1982