


WELL PLUGGING RECORD

Give All Information Completely
Make Required Affidavit
Mail or Deliver Report to:
Conservation Division
State Corporation Commission
211 No. Broadway
Wichita, Kansas

Hodgeman County, Sec. 27 Twp. 21S Rge. 22 (SW NW)
Location as "NE/CNW/SW" or footage from lines C SW NW
Lease Owner Pickrell Drilling Company
Lease Name Jarmer Well No. 1
Office Address 705 Fourth National Bank Bldg., Wichita, Kansas.
Character of Well (completed as Oil, Gas or Dry Hole) Dry Hole
Date well completed May 8, 1963
Application for plugging filed May 8, 1963
Application for plugging approved May 8, 1963
Plugging commenced May 8, 1963
Plugging completed May 8, 1963
Reason for abandonment of well or producing formation Dry Hole.

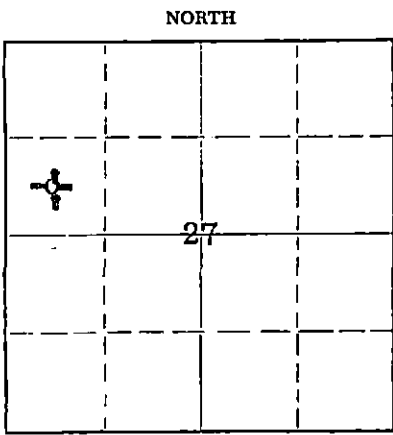

Locate well correctly on above Section Plat

If a producing well is abandoned, date of last production -- 19
Was permission obtained from the Conservation Division or its agents before plugging was commenced? Yes

Name of Conservation Agent who supervised plugging of this well
Producing formation Depth to top Bottom Total Depth of Well 4578 Feet
Show depth and thickness of all water, oil and gas formations.

OIL, GAS OR WATER RECORDS

CASING RECORD

FORMATION	CONTENT	FROM	TO	SIZE	PUT IN	PULLED OUT
		0	282'	8-5/8"	282'	None

Describe in detail the manner in which the well was plugged, indicating where the mud fluid was placed and the method or methods used in introducing it into the hole. If cement or other plugs were used, state the character of same and depth placed, from feet to feet for each plug set.

Hole filled with Mud 4578-275'
Plug 275-271'
35 sx Cement & Mud 271- 40'
Plug 40- 36'
15 sx Cement, 1/3 sk Hulls 36- 6' Bottom of Cellar.

RECEIVED
STATE CORPORATION COMMISSION

MAY 15 1963

CONSERVATION DIVISION
Wichita, Kansas

(If additional description is necessary, use BACK of this sheet)
Name of Plugging Contractor Globe Cementing Company
Address Great Bend, Kansas

STATE OF KANSAS, COUNTY OF SEDGWICK, ss.
John H. Knightley (employee of owner) or (owner or operator) of the above-described well, being first duly sworn on oath, says: That I have knowledge of the facts, statements, and matters herein contained and the log of the above-described well as filed and that the same are true and correct. So help me God.

(Signature) John H. Knightley
301 S. Broadway, Wichita, Kansas
(Address)

SUBSCRIBED AND SWORN TO before me this 14th day of May, 1963

My commission expires March 12, 1967
Stella J. Lippa Notary Public.

15.083.00050.00.00

PICKRELL DRILLING COMPANY

Jarmer #1

C SW NW Sec. 27-21S-22W
Hodgeman County, Kansas

Commenced: April 26, 1963
Completed: May 8, 1963

Casing Record: 282' 8-5/8" Cemented with 175 sacks.

Elevation: GR 2244; DF 2246; KB 2248.

Drillers Log

Surface Clay	35
Shale	282
Sand	390
Blue Shale	585
Red Bed	785
Anhydrite	815
Red Bed	880
Sand	1130
Shale & Shells	1220
Red Bed & Shale	1375
Red Bed & Anhydrite	1455
Shale & Shells	2110
Red Bed, Shale & Shells	2240
Anhydrite & Shale	2375
Shale, Lime & Shells	2515
Lime	2725
Shale & Lime	3330
Shale	3450
Shale & Lime	3870
Lime	3945
Lime & Shale	4025
Shale & Lime	4063
Lime	4200
Lime & Shale	4390
Lime, Shale, some Cherty Conglomerate	4445
Shale & Chert	4465
Chert	4485
Chert, Lime & Shale	4573
Chert	4578 RTD

RECEIVED
STATE CORPORATION COMMISSION

MAY 15 1963

CONSERVATION DIVISION
Wichita, Kansas

D&A

I hereby certify that this is a true and correct log of the above mentioned well, to the best of my knowledge and belief.

Alan H. Knightley

Subscribed and sworn to before me this 14th day of May, 1963.

Stella J. Lips
Notary Public

My commission expires 3-12-67.