

WELL PLUGGING RECORD

Give All Information Completely  
Make Required Affidavit  
Mail or Deliver Report to:  
Conservation Division  
State Corporation Commission  
211 No. Broadway  
Wichita, Kansas

HODGEMAN

County. Sec. 24 Twp. 21S Rge. (E) 22 (W)

Location as "NE/CNW4SW4" or footage from lines CENTER NE NE

Lease Owner REX & MORRIS DRILLING COMPANY AND T. A. WELLS

Lease Name McDONALD Well No. 1

Office Address P. O. BOX 334, EL DORADO, KANSAS

Character of Well (completed as Oil, Gas or Dry Hole) DRY HOLE

Date well completed 20 NOVEMBER 19 62

Application for plugging filed 20 NOVEMBER 19 62

Application for plugging approved 20 NOVEMBER 19 62


Plugging commenced 20 NOVEMBER 19 62

Plugging completed 20 NOVEMBER 19 62

Reason for abandonment of well or producing formation DRY HOLE

If a producing well is abandoned, date of last production NONE 19

Was permission obtained from the Conservation Division or its agents before plugging was commenced? YES

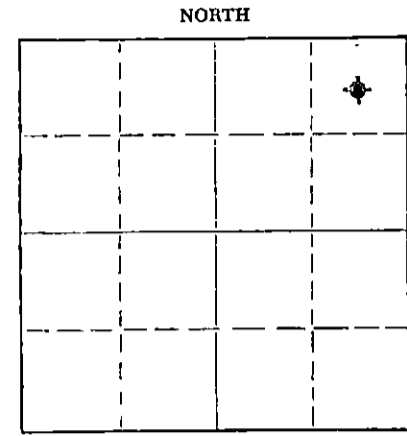

Locate well correctly on above Section Plat

Name of Conservation Agent who supervised plugging of this well HUGH SCOTT

Producing formation NONE Depth to top Bottom Total Depth of Well 4570' RB Feet

Show depth and thickness of all water, oil and gas formations.

OIL, GAS OR WATER RECORDS

CASING RECORD

FORMATION	CONTENT	FROM	TO	SIZE	PUT IN	PULLED OUT
SURFACE HOLE	WATER	SURFACE	238' RB	8 5/8" OD	232.50'	LEFT IN
(SEE ATTACHED LOG)						

Describe in detail the manner in which the well was plugged, indicating where the mud fluid was placed and the method or methods used in introducing it into the hole. If cement or other plugs were used, state the character of same and depth placed, from feet to feet for each plug set.

MIXED AND PUMPED 100 SACKS CEMENT DOWN HOLE, ON TOP OF PLUG, WITH PUMP TRUCK.

RECEIVED  
STATE CORPORATION COMMISSION

DEC 12 1962

CONSERVATION DIVISION  
Wichita, Kansas

(If additional description is necessary, use BACK of this sheet)  
Name of Plugging Contractor REX & MORRIS DRILLING COMPANY  
Address P. O. BOX 334, EL DORADO, KANSAS

STATE OF KANSAS, COUNTY OF BUTLER, ss.  
A. H. FISHER (employee of owner) or (owner or operator) of the above-described well, being first duly sworn on oath, says: That I have knowledge of the facts, statements, and matters herein contained and the log of the above-described well as filed and that the same are true and correct. So help me God.

(Signature) A. H. Fisher

P. O. BOX 334, EL DORADO, KANSAS (Address)

SUBSCRIBED AND SWORN to before me this 11TH day of DECEMBER, 19 62

My commission expires 8 AUGUST 1966

ELIZABETH DESCHNER Notary Public

Elevation 2167 RB  
2164 DF

15.083 00241 00.00

MC DONALD #1

Rex & Morris Drilling Company and  
T.A. Wells

Total Depth: 4570  
Contractor: Rex & Morris  
Commenced: 11-9-62  
Completed: 11-20-62  
Initial Prod.: D. & A.

Location: C. NE NE  
Section 24-218-22W  
Hodgeman County, Kansas

Casing Record:  
8 5/8 @ 238' :/175 sacks

FORMATION	DEPTH
Surface Hole	238
Shale	685
Anhydrite	710
Shale and Sand	1445
Shale and Shells	1910
Lime and Shale	2520
Lime	2805
Lime and Shale	3815
Lime	4370
Lime and Shale	4405
Chert and Lime	4455
Lime	4570

TD

RECEIVED  
STATE CORPORATION COMMISSION

DEC 12 1962

CONSERVATION DIVISION  
Wichita, Kansas

I hereby certify the foregoing statements are true and correct to the best of my knowledge and belief.

Rex & Morris Drilling Company

By Paul D. Koontz  
Paul D. Koontz, Geologist

STATE OF KANSAS  
COUNTY OF BUTLER, SS.

Subscribed and sworn to before me, a Notary Public, this 26th day of November, 1962.

Elizabeth Deschner  
Elizabeth Deschner, Notary Public

My commission expires: August 8, 1966