


15.083.00275.00.00

WELL PLUGGING RECORD

Give All Information Completely  
Make Required Affidavit  
Mail or Deliver Report to:  
Conservation Division  
State Corporation Commission  
211 No. Broadway  
Wichita, Kansas

HODGEMAN County. Sec. 20 Twp. 21s Rge. (X) 24(W)

NORTH

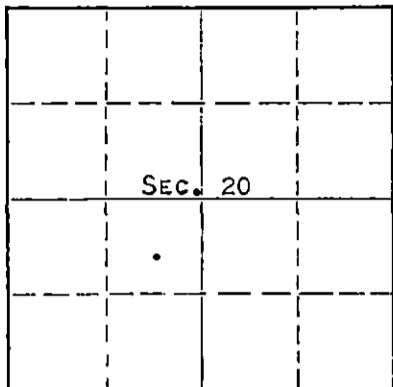

Locate well correctly on above  
Section Plat

Location as "NE/CNW\*SW\*" or footage from lines C NW SE  
Lease Owner PETROLEUM, INC.  
Lease Name ADAMS "F" Well No. 1  
Office Address ROUTE #2, GREAT BEND, KANSAS  
Character of Well (completed as Oil, Gas or Dry Hole) DRY HOLE  
Date well completed JULY 17 19 64  
Application for plugging filed JULY 30 19 64  
Application for plugging approved AUGUST 3 19 64  
Plugging commenced AUGUST 7 19 64  
Plugging completed AUGUST 13 19 64  
Reason for abandonment of well or producing formation NO PRODUCIBLE ZONES

If a producing well is abandoned, date of last production - 19-  
Was permission obtained from the Conservation Division or its agents before plugging was commenced? YES

Name of Conservation Agent who supervised plugging of this well HUGH SCOTT, SUBLETTE, KANSAS  
Producing formation \_\_\_\_\_ Depth to top \_\_\_\_\_ Bottom \_\_\_\_\_ Total Depth of Well 4540' Feet  
Show depth and thickness of all water, oil and gas formations.

OIL, GAS OR WATER RECORDS

CASING RECORD

FORMATION	CONTENT	FROM	TO	SIZE	PUT IN	PULLED OUT
MARMATON	WATER	4223'	4227'	8-5/8"	442'	NONE
MARMATON	WATER	4273'	4277'	5-1/2"	4537'	2603'
MISSISSIPPI	WATER	4466'	4476'			

Describe in detail the manner in which the well was plugged, indicating where the mud fluid was placed and the method or methods used in introducing it into the hole. If cement or other plugs were used, state the character of same and depth placed, from \_\_\_\_\_ feet to \_\_\_\_\_ feet for each plug set.

DUMPED 20 SACKS CEMENT WITH DUMP BAILER TO 4175', LOADED HOLE WITH WATER, PULLED CASING TO 700', MUD CIRCULATION ESTABLISHED WITH 15 SACKS GEL, FOLLOWED BY A METAL PLUG AND 25 SACKS CEMENT. MUDDED UP WITH HEAVY MUD TO 400', FOLLOWED BY A METAL PLUG AND 25 SACKS CEMENT. BAILED FLUID LEVEL TO 45' AND FILLED TO BASE OF WELL CELLAR WITH 15 SACKS CEMENT.

RECEIVED  
STATE CORPORATION COMMISSION 8-24-64

AUG 24 1964

CONSERVATION DIVISION  
Wichita, Kansas

(If additional description is necessary, use BACK of this sheet)  
Name of Plugging Contractor COMSTOCK CASING PULLING COMPANY  
Address STAFFORD, KANSAS

STATE OF KANSAS, COUNTY OF BARTON, ss.  
MONTE CHADD (employee of owner) or (owner) of the above-described well, being first duly sworn on oath, says: That I have knowledge of the facts, statements, and matters herein contained and the log of the above-described well as filed and that the same are true and correct. So help me God. MONTE CHADD, DIST. PROD. SUPT.  
(Signature) Monte Chadd

SUBSCRIBED AND SWORN to before me this 20TH day of AUGUST, 19 64

My commission expires SEPTEMBER 23, 1967

(Address) \_\_\_\_\_  
Shepard C. ...  
Notary Public.

# WELL LOG

13.083.00275.00.00

COMPANY Petroleum, Inc

SEC. 20 T. 21S R. 24W

FARM Adams

NO. F-1

LOC. NW SE


TOTAL DEPTH 4540'

COUNTY Hodgeman

COMM. 5-15-64

COMP. 6-1-64

CONTRACTOR Garvey Drilling Company

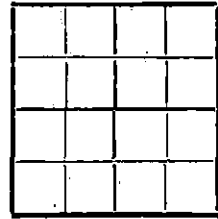

CASING 8 5/8" @ 442' w/250 sx

5 1/2" @ 4537' w/75 sx

ELEVATION 2336' DF

PRODUCTION

FIGURES INDICATE BOTTOM OF FORMATIONS

- 460' Shale
- 945' Shale, Shells and Red Bed
- 965' Anhydrite
- 1065' Shale and Sand
- 1375' Sand
- 1470' Shale, Lime, and Sand
- 1560' Shale
- 1580' Anhydrite #2
- 1800' Shale and Shells
- 2255' Shale
- 2440' Shale and Lime
- 2565' Lime
- 2670' Lime and Shale
- 2885' Lime
- 3285' Lime and Shale
- 3385' Shale and Lime
- 3515' Lime and Shale
- 3615' Shale and Lime w/Chalky Streaks
- 3677' Lime
- 3708' Lime and Chalk
- 3745' Shale and Lime
- 3855' Shale, Lime, and Chalk
- 3919' Shale and Lime
- 4392' Lime
- 4430' Lime and Chert
- 4440' Chert and Lime
- 4460' Mississippi Lime
- 4470' Mississippi Lime and Chert
- 4480' Chert
- 4500' Mississippi Chert
- 4540' Chert
- 4540' RTD

RECEIVED  
STATE CORPORATION COMMISSION

AUG 24 1964

CONSERVATION DIVISION  
Wichita, Kansas

State of Kansas

County of Barton

I, Sam N. Stephens of Garvey Drilling Company

upon oath state the above and foregoing is a true and correct copy of the log of the Adams F-1 well.

Subscribed and sworn to before me this 4th day of June 19 64

My Commission Expires: September 23rd, 1967

NOTARY PUBLIC