

STATE OF KANSAS  
STATE CORPORATION COMMISSION

15.083.20915.00.00  
WELL PLUGGING RECORD

Give All Information Completely  
Make Required Affidavit  
Mail or Deliver Report to  
Conservation Division  
State Corporation Comm.  
245 North Water  
Wichita, KS 67202

Hodgeman County, Sec. 26 Twp. 21S Rge. 24W E/W  
Location as "NE/CNW $\frac{1}{4}$ SW $\frac{1}{4}$ " or footage from lines

NE NE SW  
Lease Owner BEREXCO INC.  
Lease Name Goebel Well No. B-1

Office Address 401 E. Douglas, Suite 402, Wichita, Kansas 67202  
Character of Well (Completed as Oil, Gas or Dry Hole)

Dry Hole


Date Well completed December 23, 1981  
Application for plugging filed December 23, 1981  
Application for plugging approved December 23, 1981  
Plugging commenced December 23, 1981  
Plugging completed December 23, 1981  
Reason for abandonment of well or producing formation

Dry Hole

If a producing well is abandoned, date of last production 19

Was permission obtained from the Conservation Division or its agents before plugging was commenced? Yes

Name of Conservation Agent who supervised plugging of this well Steve Durant  
Producing formation Depth to top Bottom Total Depth of Well  
Show depth and thickness of all water, oil and gas formations.

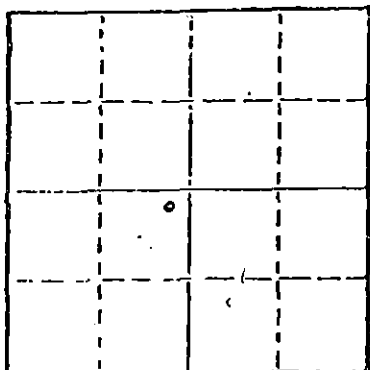

Locate well correctly on above Section Plot

OIL, GAS OR WATER RECORDS

CASING RECORD

FORMATION	CONTENT	FROM	TO	SIZE	PUT IN	PULLED OUT

Describe in detail the manner in which the well was plugged, indicating where the mud fluid was placed and the method or methods used in introducing it into the hold. If cement or other plugs were used, state the character of same and depth placed, from feet to feet for each plug set.


50-50 Pozmix, 4% Gel, 3% CC

70 sks @ 960'  
40 sks @ 570'  
Hulls & Plug 10 sks @ 40'  
5 sks RH  
5 sks MH  
PD. 9:40 P.M. 12/23/81

(If additional description is necessary, use BACK of this sheet)

Name of Plugging Contractor Halliburton

STATE OF Kansas COUNTY OF SEDGWICK, ss.  
Jerome D. Marcus (employee of owner) or (owner or operator)  
of the above-described well, being first duly sworn on oath, says: That I have knowledge of the facts, statements, and matters herein contained and the log of the above-described well as filed and that the same are true and correct. So help me God.

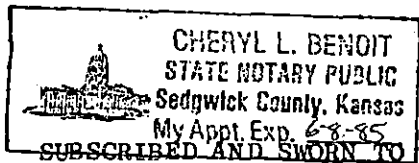

(Signature)

*[Handwritten Signature]*

(Address) RECEIVED  
STATE CORPORATION COMMISSION  
19 82

SUBSCRIBED AND SWORN TO before me this 4th day of January, 1982

*[Handwritten Signature]* - 7 1982

Notary Public.  
CONSERVATION DIVISION  
Wichita Kansas

My commission expires 6-8-85

1-7-82