


KANSAS  
 STATE CORP. STATION COMMISSION  
 Completely  
 Give All Information  
 Make Required Report to:  
 Mail or Delivery Division  
 Conservation Commission  
 State Highway  
 211 N. Kansas  
 Wichita

15.083.00027.00.00  
**WELL PLUGGING RECORD**

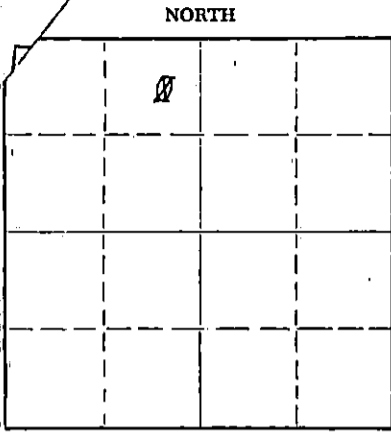

Locate well correctly on above Section Plat

HODGEMAN County. Sec. 23 Twp. 21S Rge. 24 ~~W~~ (W)  
 Location as "NE/CNW/SW" or footage from lines NE NE NW  
 Lease Owner V. E. SPRADLIN  
 Lease Name GOEBEL Well No. 1  
 Office Address UNION CENTER BLDG. WICHITA, KANSAS  
 Character of Well (completed as Oil, Gas or Dry Hole) DRY HOLE  
 Date well completed OCTOBER 25 19 60  
 Application for plugging filed OCTOBER 25 19 60  
 Application for plugging approved OCTOBER 25 19 60  
 Plugging commenced OCTOBER 25 19 60  
 Plugging completed OCTOBER 26 3:00 AM 19 60  
 Reason for abandonment of well or producing formation DRY HOLE

If a producing well is abandoned, date of last production NONE 19  
 Was permission obtained from the Conservation Division or its agents before plugging was commenced? YES

Name of Conservation Agent who supervised plugging of this well LOU BROCK  
 Producing formation \_\_\_\_\_ Depth to top \_\_\_\_\_ Bottom \_\_\_\_\_ Total Depth of Well 4550 Feet  
 Show depth and thickness of all water, oil and gas formations.

**OIL, GAS OR WATER RECORDS**

**CASING RECORD**

FORMATION	CONTENT	FROM	TO	SIZE	PUT IN	PULLED OUT
				8 5/8	268'	CEMENTED TOP TO BOTTOM

Describe in detail the manner in which the well was plugged, indicating where the mud fluid was placed and the method or methods used in introducing it into the hole. If cement or other plugs were used, state the character of same and depth placed, from \_\_\_\_\_ feet to \_\_\_\_\_ feet for each plug set.

HEAVY MUD FROM BOTTOM TO 240'. HOLE BRIDGED & PUT IN 20 SACKS OF CEMENT. HOLE BRIDGED AT 30' & 15 SACKS OF CEMENT PUT IN HOLE. 5 SACKS CEMENT PUT IN RAT HOLE.

RECEIVED  
 STATE CORP. STATION COMMISSION

NOV 2 1960

CONSERVATION DIVISION  
 Wichita, Kansas

11-2-60

(If additional description is necessary, use BACK of this sheet)

Name of Plugging Contractor CHEROKEE DRILLING CO., INC.  
 Address Box 631, EL DORADO, KANSAS

STATE OF Kansas, COUNTY OF Sedgwick, ss.  
Virgil E. Spradlin (employee of owner) or (owner or operator) of the above-described well, being first duly sworn on oath, says: That I have knowledge of the facts, statements, and matters herein contained and the log of the above-described well as filed and that the same are true and correct. So help me God.

(Signature) Virgil E. Spradlin  
312 Union Center, Wichita, Kan.  
 (Address)

SUBSCRIBED AND SWORN TO before me this 1st day of November, 19 60

Helen Horine  
 Helen Horine Notary Public.

My commission expires June 4, 1963

