


WELL PLUGGING RECORD

Give All Information Completely
Make Required Affidavit
Mail or Deliver Report to:
Conservation Division
State Corporation Commission
800 Bittling Building
Wichita, Kansas

NORTH

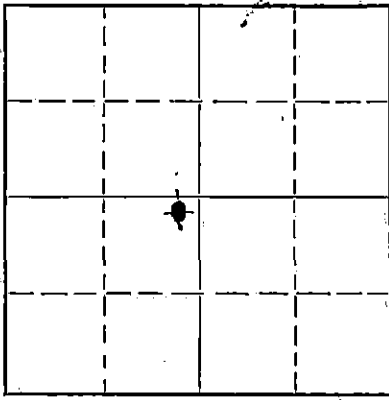

Locate well correctly on above Section Plat

Reno County. Sec. 26 Twp. 23 Rge. (E) 10 (W)
Location as "NE/CNW 1/4 SW 1/4" or footage from lines NE NE SW
Lease Owner Nadel and Gussman
Lease Name Paine Well No. 1
Office Address Drawer 309, Tulsa 1, Oklahoma
Character of Well (completed as Oil, Gas or Dry Hole) Dry Hole
Date well completed October 8 19 52
Application for plugging filed October 8 19 52
Application for plugging approved October 17 19 52
Plugging commenced October 8 19 52
Plugging completed October 15 19 52
Reason for abandonment of well or producing formation

If a producing well is abandoned, date of last production 19
Was permission obtained from the Conservation Division or its agents before plugging was commenced? Yes

Name of Conservation Agent who supervised plugging of this well M. A. Rives, Box 118, Pratt, Kansas
Producing formation Depth to top Bottom Total Depth of Well 4250 Feet
Show depth and thickness of all water, oil and gas formations.

OIL, GAS OR WATER RECORDS

CASING RECORD

Formation	Content	From	To	Size	Put In	Pulled Out
				8 5/8"	229'	None
				5 1/2"	3845'	2752'

Describe in detail the manner in which the well was plugged, indicating where the mud fluid was placed and the method or methods used in introducing it into the hole. If cement or other plugs were used, state the character of same and depth placed, from feet to feet for each plug set.

Plugged back from 4250' to 3590'. From 3590' to 3500' with sand. From 3500' to 3465' with 5 sacks of cement. From 3465' to 250' with heavy mud. From 250' to 240' permanent rock bridge. From 240' to 180' with 20 sacks cement. From 180' to 35' with heavy mud. From 35' to 30' with rockbridge. 30' to Bottom of Cellar with 10 sacks of cement.

RECEIVED
STATE CORPORATION COMMISSION

10-29-52

10-29-52

(If additional description is necessary, use BACK of this sheet)

Correspondence regarding this well should be addressed to Nadel and Gussman
Address Drawer 309, Tulsa 1, Oklahoma


STATE OF Oklahoma, COUNTY OF Tulsa, ss.
Herbert Gussman (employee of owner) or (owner or operator) of the above-described well, being first duly sworn on oath, says: That I have knowledge of the facts, statements, and matters herein contained and the log of the above-described well as filed and that the same are true and correct. So help me God.

(Signature) *Herbert Gussman*
Drawer 309, Tulsa 1, Oklahoma
(Address)

SUBSCRIBED AND SWORN to before me this 28th day of October, 1952

My commission expires April 1, 1953.

Notary Public.

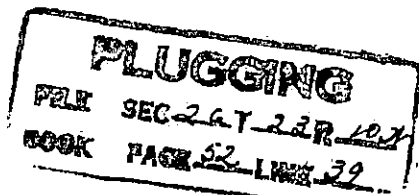

WELL LOG

15-159-60353-01

PATNE #1 WELL
NE/c SW/4 Section 26-23-10W
Reno County, Kans.

Nadel and Gussman
Tulsa, Oklahoma

Casing: 8-5/8" 229' - Left in Hole - 229'
5-1/2" 3845' - Left in Hole - 1093'

Commenced: 12-1-44 Completed: 12/26/44

Deepened - 10/8/52 to 4250'
Plugged - 10/15/52

rotary bushing 0
surface clay & sand 40
surface sand 170
red rock 250
red rock & shells 430
anhydrite 450
shale & lime shells 1220
shale & lime brkn 1560
lime brkn 1640
lime brkn & shale 1760
sand 1780
lime brkn 1885
shale 1915
lime brkn 1940
lime brkn & shale 2075
lime brkn 2490
shale 2520
lime brkn 2615
lime brkn & shale 2785
lime 2800
lime brkn 2810
lime 2990
lime & shale 3020
lime brkn 3120
lime brkn & shale 3130
lime brkn 3160
shale & shells 3230
shale 3300
lime brkn & shale 3320
lime brkn 3330
lime 3590
shale & shells 3625
shale & chert 3645
lime cherty 3685
shale 3818
lime 3876
lime & chert 3890
lime 3927
shale 3945
sand 3949
shale 3999
lime 4049
Total Depth 4250

Tops from Rotary Bushing

Lansing 3299
Miss 3640
Kinderhook 3681
Viola 3818
Simpson 3928
Arbuckle 3999
Plugged Back Depth 3590'
Perforated 3516 to 3520

OCT 2 1952

CONSERVATION DIVISION
Tulsa, Kansas

PLUGGING
