


WELL PLUGGING RECORD

Give All Information Completely
Make Required Affidavit
Mail or Deliver Report to:
Conservation Division
State Corporation Commission
800 Bittling Building
Wichita, Kansas

Reno County, Sec. 26 Twp. 23 Rge. 10 (E) W (W)

Location as "NE/CNW/SW" or footage from lines NW NE SW
Lease Owner Nadel and Gussman
Lease Name Paine Well No. 2
Office Address P. O. Box 309, Tulsa, Oklahoma
Character of Well (completed as Oil, Gas or Dry Hole) Dry
Date well completed 10-21-52
Application for plugging filed 10-21-52
Application for plugging approved 10-21-52
Plugging commenced 10-21-52
Plugging completed 10-21-52
Reason for abandonment of well or producing formation Dry

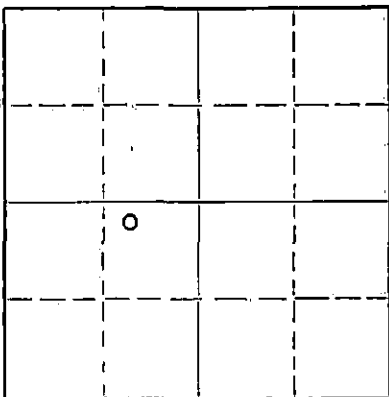

Locate well correctly on above Section Flat

If a producing well is abandoned, date of last production 19
Was permission obtained from the Conservation Division or its agents before plugging was commenced? Yes

Name of Conservation Agent who supervised plugging of this well Ruel Durkee
Producing formation _____ Depth to top _____ Bottom _____ Total Depth of Well 3682 Feet
Show depth and thickness of all water, oil and gas formations.

OIL, GAS OR WATER RECORDS

CASING RECORD

FORMATION	CONTENT	FROM	TO	SIZE	PUT IN	PULLED OUT
				8-5/8	270	0

Describe in detail the manner in which the well was plugged, indicating where the mud fluid was placed and the method or methods used in introducing it into the hole. If cement or other plugs were used, state the character of same and depth placed, from _____ feet to _____ feet for each plug set.

Filled hole with heavy mud from 3682 to 230'

Set Plug with 20 sacks cement at 240'

Set plug with 10 sacks cement at 35'

RECEIVED
STATE CORPORATION COMMISSION

OCT - 9 1952

10-9-52

CONSERVATION DIVISION
Wichita, Kansas

(If additional description is necessary, use BACK of this sheet)

Name of Plugging Contractor Reserve Drilling Company, Inc.
Address 703 Union National Bank Building, Wichita 2, Kansas

STATE OF KANSAS COUNTY OF SEDGWICK, ss.
L. C. Hay (employee of owner) or (owner or operator) of the above-described well, being first duly sworn on oath, says: That I have knowledge of the facts, statements, and matters herein contained and the log of the above-described well as filed and that the same are true and correct. So help me God.

(Signature) L. C. Hay

(Address)

SUBSCRIBED AND SWORN TO before me this 6th day of October, 1952

My commission expires Nov. 3, 1952

Notary Public.

24-2675-S 2-52-20M
PLUGGING
FILE SEC 26 T 23 R 10
BOOK PAGE 50 LINE 6

WELL LOG

15-155-00363-0000

NADEL AND GUSSMAN

PAINES No. 2

NW NE SW 26-23-10W
Reno County, Kansas

Comm: 9-21-52
Comp: 10-2-52

Casing: 8-5/8" 270' w/150 Sex

Sand and surface clay	198
Red bed	270
Red bed, shale and shells	417
Anhydrite	445
Shale and lime shells	1450
Ft. Riley Lime	1605
Lime and shale	1720
Sandy lime and shale	1795
Lime and shale	1945
Shale and lime shells	2140
Lime	2190
Shale and lime shells	2315
Lime and shale	2480
Shale and lime shells	2785
Lime and shale	2810
Lime	2950
Lime and shale	3274
Lime	3583
Lime and shale	3613
Lime	3655
Lime and chert	3682

GEOLOGICAL TOPS

Brown Lime	3274
Lansing-Kansas C.	3299
Miss. Chat	3644

STATE OF KANSAS)
) SS:
COUNTY OF SEDGWICK)

L. C. Ray, of lawful age, deposes and states that the above formations and depths are correct as shown by the daily drilling log of the Paines No. 2 Well in the NW NE SW of 26-23-10W, Reno County, Kansas.

L. C. Ray

Subscribed and sworn to before me this 15th day of October, 1952.

STATE CORPORATION COMMISSION

Walter Bess
Notary Public

My commission expires Nov. 3, 1953

CONSERVATION DIVISION
Wichita, Kansas

PLUGGING
WELL NO. 26-23-10W-2
BOOK PAGE 50 LINE 6