

WELL PLUGGING RECORD

Give All Information Completely
Make Required Affidavit
Mail or Deliver Report to:
Conservation Division
State Corporation Commission
800 Bitting Building
Wichita, Kansas

Reno County. Sec. 28 Twp. 23 Rge. 10 (E) W (W)

Location as "NE/CNW/SW" or footage from lines 990' S. & 990' W. of N/4 Cor.

Lease Owner Cities Service Oil Company

Lease Name Kreie "E" Well No. 1

Office Address Great Bend, Kansas

Character of Well (completed as Oil, Gas or Dry Hole) Oil Well

Date well completed May 17, 19 42

Application for plugging filed January 12, 19 56

Application for plugging approved January 13, 19 56


Plugging commenced January 13, 19 56

Plugging completed January 21, 19 56

Reason for abandonment of well or producing formation Depleted formation

If a producing well is abandoned, date of last production July 11, 19 55

Was permission obtained from the Conservation Division or its agents before plugging was commenced? Yes

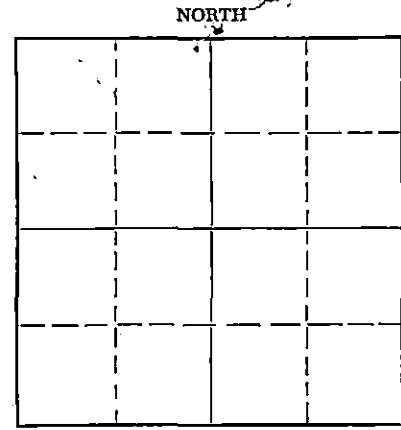

Locate well correctly on above Section Plat

Name of Conservation Agent who supervised plugging of this well Ruel Durkee

Producing formation Viola Depth to top 3781 Bottom 3791 Total Depth of Well 3791 Feet

Show depth and thickness of all water, oil and gas formations.

OIL, GAS OR WATER RECORDS

CASING RECORD

FORMATION	CONTENT	FROM	TO	SIZE	PUT IN	PULLED OUT
				8-5/8"	233'	None
				5-1/2"	3782'	1611'

Describe in detail the manner in which the well was plugged, indicating where the mud fluid was placed and the method or methods used in introducing it into the hole. If cement or other plugs were used, state the character of same and depth placed, from _____ feet to _____ feet for each plug set.

3791-3770 sand
3770-3722 6 sacks cement
3722- 220 mud
220- 205 rock bridge
205- 165 15 sacks cement
165- 12 mud
12' to base of cellar, 5 sacks cement

(If additional description is necessary, use BACK of this sheet)

Name of Plugging Contractor Wilson, Inc. - Chas. D. Wilson, Operator

Address 2921 Bonita, Great Bend, Kansas

STATE OF Kansas, COUNTY OF Barton, ss.

V. M. Conover (employee of owner) or owner or operator of the above-described well, being first duly sworn on oath, says: That I have knowledge of the facts, statements, and matters herein contained and the log of the above-described well as filed and that the same are true and correct. So help me God.

(Signature) V. M. Conover

Box 751, Great Bend, Kansas
(Address)

SUBSCRIBED AND SWORN to before me this 27th day of January, 19 56

My commission expires March 12, 1959

W. G. Smith
Notary Public.

24-7368-S 3-53-20M

PLUGGING
FILE SEC 28 T 23 R 10W
BOX PAGE 31 LINE 7

JAN 20 1956 1-28-56
CONSERVATION DIVISION
Wichita, Kansas

15-155-02263-0000

Company Cities Service Oil Co. Well No. 1 Farm Krois #31
 Location 990' south & 990' west of N/4 Corner Sec. 28 T. 23 R. 10N
 Elevation 1782 County Reno State Kansas
 Drlg. Comm. April 22, 1942 Contractor Higson Drilling Company
 Drlg. Comp. May 17, 1942 Acid 500 gals. 5-14-42; 500 gals. 5-19-42.
 T. D. 3791' Initial Prod. Physical Potential: 132 oil, 73 water, 24 hrs.

CASING RECORD:

8-5/8" @ 233' cem. 175 ex Lone Star
 5-1/2" @ 3782' cem. 75 ex Cement

FORMATION RECORD:

surface clay & sand	0-125
red rock & shale	230
lime shells	233
shale, red bed & shells	855
shale & shells	1290
salt & shale	1360
broken lime & shale	1405
shale & lime	1550
broken lime & shale	2077
lime & shale	2180
broken lime & shale	2426
shale & shells	2506
shale	2530
broken lime & shale	2665
shale & shells	2720
shale	2745
lime & shale	2810
shale	2840
broken lime	2922
broken lime & shale	2944
lime	3128
broken lime & shale	3216
lime & shale	3225
shale	3288
broken lime & shale	3425
lime & shale	3476
lime	3565
shale	3570
shale & lime	3615
shale	3626
shale & lime	3629
chert	3661
shale	3664
shale & shells	3770
shale	3784
lime	3785

3785 Rot. TD = 3783 BLM
 lime 3791 T. D.

Corr. Top Viola 3781'
 Penetration 10'
 Total Depth 3791'

Loaded hole with 2500' water
 before drilling in.

Small show oil 3786-87, no
 fillup.

SYFO: 500' 0°
 1000' 0°
 1500' 0°
 2500' 0°
 3000' 0°
 3500' 0°

RECEIVED
 JAN 15 1945
 DIVISION
 Wita, Kansas

RECEIVED
 JAN 17 1946
 DIVISION
 Wita, Kansas

PLUGGING
 FILE SEC 28 T 23 R 10W
 BOOK PAGE 31 LINE 7