

STATE OF KANSAS
STATE CORPORATION COMMISSION

WELL PLUGGING RECORD

Give All Information Completely.
Make Required Affidavits.
Mail or Deliver Report to:
Conservation Division
State Corporation Commission
800 Bitting Building
Wichita, Kansas

OR

FORMATION PLUGGING RECORD

Strike out upper line
when reporting plug-
ging of formations.

~~XXXX~~ Reno County. Sec. 28 Twp. 23 Rge. (E) 10 (W) X

Location as "NE $\frac{1}{4}$ NW $\frac{1}{4}$ SW $\frac{1}{4}$ " or footage from lines. 330 S. of N. line 880 W. of E. line of SW $\frac{1}{4}$

Lease Owner: Leland Fikes

Lease Name: Hollandback Well No. #5

Office Address: 506 Continental Bldg, Dallas, Texas

Character of Well (completed as Oil, Gas or Dry Hole): Dry Hole

Date well completed: 10-23-1948

Application for plugging filed: 19. X

Application for plugging approved: 19. X


Plugging commenced: December 18 19. 48

Plugging completed: December 24 19. 48

Reason for abandonment of well or producing formation: Dry Hole

If a producing well is abandoned, date of last production: 19.

Was permission obtained from the Conservation Division or its agents before plugging was commenced? Yes

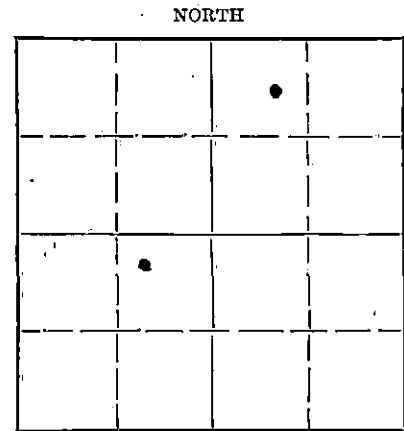

Locate well correctly on above
Section Plat

Name of Conservation Agent who supervised plugging of this well: R. Durkee

Producing formation: Depth to top: Bottom: Total Depth of Well: 3806 Feet

Show depth and thickness of all water, oil and gas formations.

OIL, GAS OR WATER RECORDS

CASING RECORD

Formation	Content	From	To	Size	Put In	Pulled Out
Viola	Water	3770'	3806	8 5/8"	286	None
				5 1/2"	3791	3127' 5"

Describe in detail the manner in which the well was plugged, indicating where the mud fluid was placed and the method or methods used in introducing it into the hole. If cement or other plugs were used, state the character of same and depth placed, from _____ feet to _____ feet for each plug set.

Rocked hole from 3806' to 3790'. Run 6 sacks of cement.
Mudded hole to 275' of top. Run 15 sacks of cement.
Mudded hole to top. Run 5 sacks of cement.
Well Completed.

RECEIVED

1-3-49

JAN 3 1949

STATE CORPORATION
COMMISSION
KANSAS

(If additional description is necessary, use BACK of this sheet)

Correspondence regarding this well should be addressed to: Leland Fikes

Address: 506 Continental Bldg
Dallas, Texas

STATE OF KANSAS, COUNTY OF BARTON, ss.

(employee of owner) or (owner or operator) of the above-described well,
being first duly sworn on oath, says: That I have knowledge of the facts, statements, and matters herein contained and the log of the above-described well as filed and that the same are true and correct. So help me God.

(Signature) A. D. G. ...

Hoisington, Kansas.


(Address)

SUBSCRIBED AND SWORN to before me this 31 day of December, 19 48

Bernice L. ...

Notary Public.

My commission expires April 23, 1951

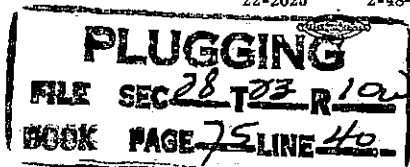

NW Hollenback #5
NE NE SW Section 28-23-10
Reno County, Kansas
Leland Fikes

15-155-62057-0000

Commenced: September 27, 1948
 Completed: October 10, 1948

Surface, sand	0	45
Sand and gravel	45	115
Red bed and sand	115	165
Red rock and red bed	165	281
Red bed and shale	281	450
Sand and lime	450	480
Shale	480	525
Shale	525	730
Anhydrite	730	745
Shale and shells	745	830
Shale and anhydrite	830	875
Shale and shells	875	1010
Shale and shells	1010	1330
Lime	1330	1490
Fort Riley	1490	1540
Lime	1540	1600
Lime - broken	1600	1740
Lime	1740	1850
Lime	1850	1965
Lime	1965	2060
Shale and lime	2060	2115
Lime and shale	2115	2235
Lime and shale	2235	2345
Shale and shells	2345	2375
Shale and shells	2375	2495
Broken lime	2495	2510
Broken lime	2510	2610
Lime and shale	2610	2695
Shale and shells	2695	2730
Lime and shale	2730	2750
Shale and lime	2750	2850
Lime	2850	2925
Lime and shale	2925	3010
Lime and shale	3010	3070
Lime	3070	3125
Lime and shale	3125	3200
Lime and shale	3200	3275
Shale	3275	3320
Lime	3320	3335
Lime	3335	3385
Lime and shale	3385	3425
Lime	3425	3480
Lime	3480	3525
Lime	3525	3550
Lime	3550	3605
Lime	3605	3630
Lime and chert	3630	3663
Lime and chert	3663	3673
Shale	3673	3725
Shale	3725	3780
Shale	3780	3791
Lime	3791	3792
TOTAL DEPTH	3792	

RECEIVED

JAN 11 1949
 STATE REGISTRATION
 COMMISSION
 KANSAS

CASING RECORD

8-5/8" casing set at 281' and
 cemented with 125 sacks of cement

5-1/2" casing set at 3792' and
 cemented with 100 sacks of cement

15-155-62057-0000

STATE OF KANSAS

SS:

COUNTY OF ELLIS

I hereby affirm that the above and foregoing is a true and correct copy of the log of your Hollenback #5 well located in the NE-NE-SW of Section 28-23-10, Reno County, Kansas.

A-B-W DRILLING COMPANY, INC.

By Paul Ward

Subscribed and sworn to before me, a Notary Public, this 14th day of October, 1948.

Mildred M. Bauer
Notary Public

My Commission Expires May 26, 1952

RECEIVED

Corporation Div.

JAN 11 1949

STATE CORPORATION

COMMISSION

KANSAS