

15-155-01981-0000


STATE OF KANSAS  
STATE CORPORATION COMMISSION  
Give All Information Completely  
Make Required Affidavit  
Mail or Deliver Report to:  
Conservation Division  
State Corporation Commission  
800 Bitting Building  
Wichita, Kansas

WELL PLUGGING RECORD  
OR  
FORMATION PLUGGING RECORD

Strike out upper line  
when reporting plugging  
off formations.

Reno County, Sec. 28 Twp. 23 Rge. 10 (E) W.(W)

NORTH

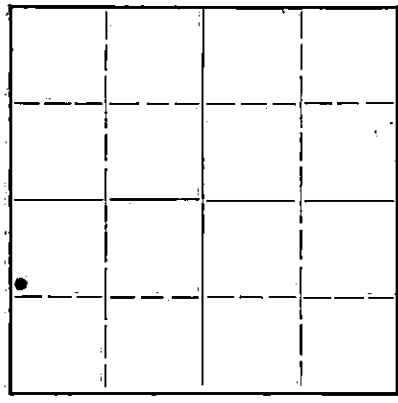

Locate well correctly on above  
Section Plat

Location as "NE 1/4 NW 1/4 SW 1/4" or footage from lines SW NW SW  
Lease Owner: Auto-Ordnance Corporation - Oil Division  
Lease Name: Hollenback #2 Well No. 2  
Office Address: 517 Union Nat'l Bank Bldg., Wichita 2, Kansas  
Character of Well (completed as Oil, Gas or Dry Hole)  
Date well completed: September 1, 1943  
Application for plugging filed: August 27, 1943  
Application for plugging approved: August 27, 1943  
Plugging commenced: August 27, 1943  
Plugging completed: September 1, 1943  
Reason for abandonment of well or producing formation: Dry Hole

If a producing well is abandoned, date of last production: 19  
Was permission obtained from the Conservation Division or its agents before plugging was commenced? Yes

Name of Conservation Agent who supervised plugging of this well: Ruel Durkee  
Producing formation: Viola Depth to top: 3783 Bottom: 3810 Total Depth of Well: 3810 Feet  
Show depth and thickness of all water, oil and gas formations.

OIL, GAS OR WATER RECORDS

CASING RECORD

Formation	Content	From	To	Size	Put In	Pulled Out
				8 5/8"	283'	None (Cemented)
				5 1/2"	3784'	2907'

Describe in detail the manner in which the well was plugged, indicating where the mud fluid was placed and the method or methods used in introducing it into the hold. If cement or other plugs were used, state the character of same and depth placed, from 3810 feet to 3765 feet for each plug set.

Cement 3810 to 3765 (6 sax)  
Mud 3765 to 250  
Cement 250 to 225 (8 sax)  
Mud 225 to 15  
Cement cap 15 to cellar base (4 sax)

28 23 10 W  
9-0 HL-4-0

(If additional description is necessary, use BACK of this sheet)

Correspondence regarding this well should be addressed to Auto-Ordnance Corporation, - Oil Division  
Address: 517 Union National Bank Building, Wichita 2, Kansas

STATE OF Kansas, COUNTY OF Sedgwick, ss.

(employee of owner) or (owner or operator) of the above-described well, being first duly sworn on oath, says: That I have knowledge of the facts, statements, and matters herein contained and the log of the above-described well as filed and that the same are true and correct. So help me God.

(Signature) Ruel Durkee 9-10-43

517 Union Nat'l Bank Bldg., Wichita 2, Kansas (Address)

SUBSCRIBED AND SWORN to before me this 9th day of Sept 1943

Scott Stucky Notary Public

My commission expires 2-2-1944

WELL LOG BUREAU - KANSAS GEOLOGICAL SOCIETY  
412 Union National Bk Bldg., Wichita, Kansas


15-155-01981-0000

AUTO-ORDNANCE CORP.  
Hollenbeck No. 2.

SEC. 28 T. 23 R. 10 W  
SW NW SW

Total Depth. 3810'  
Comm. 10-8-42 Comp. 12-7-42  
Shot or Treated.  
Contractor. Ingling & Parker  
Issued. 12-26-42 Rotary 0-3785

County. Reno

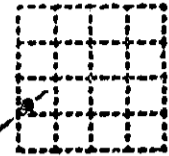

CASING:  
8 5/8" 283'  
5 1/2" 3784'

Elevation.

Production. Dry

Figures Indicate Bottom of Formations.

surface clay	40
sand & gravel	105
red rock, sand, shells	250
red rock, lime, shells	283
red bed & shells	300
red bed & shale	770
shaly shale	880
shale & sand	1090
shale & salt	1335
lime & shale	1480
sand & lime hd	1545
shale & lime	1580
sand hd	1630
sand hd & lime	1712
lime & shale	1810
lime shaly	1825
lime & shale	1895
lime	1942
shale	1960
lime	2190
lime brkn	2207
lime	2250
brkn lime & shale	2280
shale & lime	2793
lime	3025
shale & lime	3090
lime	3135
lime & shale	3250
shale	3280
shale & lime	3374
lime	3396
shale	3401
lime brkn	3408
lime	3549
lime hd	3558
lime cherty	3570
lime & chert	3591
shale & lime	3613
shale	3634
chert	3656
lime & shale hd	3663
shale	3783
lime Viola	3810
Total Depth.	

Tops:  
Lime 3312  
Mississippi 3630  
Base Mississippi 3660  
Viola 3783

28 23 10 W  
90 40