


Give All Information Completely
Make F...red Affidavit
Mail or...port to:
Conservation Division
State Corporation Commission
800 Bitting Building
Wichita, Kansas

OR
FORMATION PLUGGING RECORD

Strike out upper line
when reporting plug-
ging off formations.

NORTH

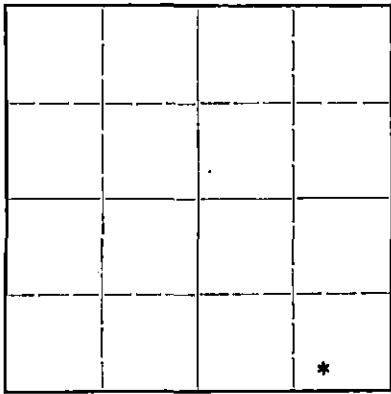

Locate well correctly on above
Section Plat

Reno County. Sec. 30 Twp. 23 Rge. 10 (W)
Location as "NE 1/4 NW 1/4 SW 1/4" or footage from lines. SW SE SE
Lease Owner. Mid-Continent Petroleum Corporation
Lease Name. Opal Hartnett Well No. 1
Office Address. Box 1362, Wichita 1, Kansas.
Character of Well (completed as Oil, Gas or Dry Hole). Oil Well
Date well completed. December 8, 19.44
Application for plugging filed. January 8, 19.47
Application for plugging approved. January 9, 19.47
Plugging commenced. January 27, 19.47
Plugging completed. February 4, 19.47
Reason for abandonment of well or producing formation. Well was making only
one barrel of oil and 12 barrels of water daily.
If a producing well is abandoned, date of last production. January 15, 19.47
Was permission obtained from the Conservation Division or its agents before plugging was com-
menced? Yes

Name of Conservation Agent who supervised plugging of this well. Mr. Rural Durkee, McPherson, Kansas.
Producing formation. Viola Lime Depth to top. 3655' Bottom. 3729' Total Depth of Well. 3729' Feet
Show depth and thickness of all water, oil and gas formations.

OIL, GAS OR WATER RECORDS

CASING RECORD

Formation	Content	From	To	Size	Put In	Pulled Out
Viola Lime	Oil & Water	3678'	3695'	10 1/2" 7"OD	225' 3722'	none 2784'

Describe in detail the manner in which the well was plugged, indicating where the mud fluid was placed and the method or methods used in introducing it into the hold. If cement or other plugs were used, state the character of same and depth placed, from... feet to... feet for each plug set.
Hole filled with sand from 3696' (top of cement in pipe) to 3675'
6 sacks of cement dumped with dump bailer from 3675' to 3645'
Hole mudded by hand from 3645' to 220'
Rock bridge at 220'
20 sacks of cement dumped with dump bailer from 220' to 180'
Hole mudded from 180' to 15'
Hole filled with cement from 15' to 5' (Bottom of cellar)
Cellar to be filled to ground level.

Lloyd Snyder
2-6-47

PLUGGING
FILE 30 23 10W
BOOK 91 32

(If additional description is necessary, use BACK of this sheet)
Correspondence regarding this well should be addressed to Mr. Lloyd Snyder.
Address. Box 1362, Wichita 1, Kansas. 2-7-47

STATE OF Kansas, COUNTY OF Barton, ss.
A.E. Johnson (employee of owner) or (owner) of the above-described well,
being first duly sworn on oath, says: That I have knowledge of the facts, statements, and matters herein contained and the log of the above-described well as filed and that the same are true and correct. So help me God.

(Signature) *A.E. Johnson*
Ellinwood, Kansas, R.R. # 1
(Address)

SUBSCRIBED AND SWORN to before me this 5th day of February, 19.47

My commission expires Oct 28 1948

The Wherry 1947
Notary Public.

DISTRICT OFFICE

FEB 6 1947

Wichita, Kansas

COMPANY - Mid-Continent Petroleum Corp.
 FARM - Opal Hartnett No. 1

Sec. 30 T. 23 R. 10W
 SW SE SE

Total Depth - 3729'
 Comm. 11-10-44 Comp. 11-29-44
 Shot or treated - 500 gal. acid
 Contractor - Barnett Drilling Co.

COUNTY - Reno

Elevation 1796

CASING:
 10 3/4" New S.S. 225'
 7" 24# S.H.S.S. 3722'6"

Production 186 bbl.

15-155-02269-0000

Sand	0	160
Red bed	160	238
Red bed	238	368
Shale & shells	368	1635
Lime	1635	1720
Broken lime	1720	1800
Lime	1800	1910
Lime & shale	1910	1985
Lime	1985	2155
Broken lime & shale	2155	2255
Lime	2255	2295
Lime & shale	2295	2425
Shale & lime shells	2425	2585
Broken lime	2585	2592
Shale & shells	2592	2598
Lime & shale	2598	2697
Lime	2697	2760
Sandy lime	2760	2810
Lime	2810	3007
Sandy lime	3007	3017
Lime	3017	3125
Shale	3125	3140
Lime	3140	3175
Broken lime & shale	3175	3300
Lime, K.C.	3300	3624
Conglomerate	3624	3655
Lime, Viola	3655	3677
Lime, Viola	3677	3678
Lime, Viola	3678	3680
Lime, "	3680	3681
Lime, "	3681	3682
Lime, "	3682	3690
Lime, "	3690	3701
Sand Simpson	3701	3710
Lime	3710	3729
TOTAL DEPTH	3729	

30 23 10W
 91 32

