


WELL PLUGGING RECORD

Give All Information Completely  
Make Required Affidavit  
Mail or Deliver Report to:  
Conservation Division  
State Corporation Commission  
800 Biltmore Building  
Wichita, Kansas

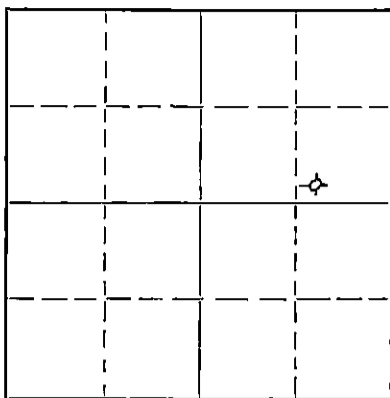

Locate well correctly on above Section Plat

Reno County, Sec. 30 Twp. 22S Rge. 9W (W)  
Location as "NE/CNW $\frac{1}{4}$ SW $\frac{1}{4}$ " or footage from lines SW se ne  
Lease Owner PICKRELL DRILLING CO. INC., & RALPH J. WEAVER, Jr. et al  
Lease Name Leslie "B" Well No. 1  
Office Address 705 4th Nat'l Bank Bldg., Wichita 2, Kansas.  
Character of Well (completed as Oil, Gas or Dry Hole) Dry Hole  
Date well completed 1/22 19 50  
Application for plugging filed 1/22 19 50  
Application for plugging approved 1/22 19 50  
Plugging commenced 2:00 P.M. 1/22 19 50  
Plugging completed 1/22 19 50  
Reason for abandonment of well or producing formation D. & A  
If a producing well is abandoned, date of last production 19  
Was permission obtained from the Conservation Division or its agents before plugging was commenced? Yes

Name of Conservation Agent who supervised plugging of this well Ruel Durkee  
Producing formation Depth to top Bottom Total Depth of Well 3854 Feet  
Show depth and thickness of all water, oil and gas formations.

OIL, GAS OR WATER RECORDS

CASING RECORD

Formation	Content	From	To	Size	Put In	Pulled Out
				8 5/8"	248'	None
				No oil string run.		

Describe in detail the manner in which the well was plugged, indicating where the mud fluid was placed and the method or methods used in introducing it into the hole. If cement or other plugs were used, state the character of same and depth placed, from feet to feet for each plug set.

Pumped heavy mud in hole to 245'. Set bridge and cemented with 15 sacks. Mudded hole to 20', set bridge and cemented with 10 sacks to bottom of cellar.

RECEIVED

JAN 25 1950

1-25-50

STATE CORPORATION COMMISSION  
KANSAS

(If additional description is necessary, use BACK of this sheet)

Correspondence regarding this well should be addressed to Pickrell Drilling Company, Inc.  
Address 705 Fourth National Bank Bldg., Wichita 2, Kansas

STATE OF KANSAS, COUNTY OF SEDGWICK, ss.

C. W. Sebitts (employee of owner) or (owner) of the above-described well, being first duly sworn on oath, says: That I have knowledge of the facts, statements, and matters herein contained and the log of the above-described well as filed and that the same are true and correct. So help me God.

(Signature)

705 4th National Bank Bldg., Wichita 2, Kansas.  
(Address)

SUBSCRIBED AND SWORN to before me this 24th day of January, 19 50.

Ethel Zimmerman  
Notary Public.

My commission expires January 28, 1953.

22-7377-5 4-19-10M  
PLUGGING  
FILE SEC 30 T 22 R 9 W  
BOOK PAGE 134 LINE 41

COMPANY: RALPH J. WEAVER, JR., Notary Drilling Commenced: 1-11-50  
 PICKRELL DRILLING COMPANY, INC. Notary Drilling Completed: 1-22-50  
 AND OTHERS.

LOCATION: LINDSEY "B" #1  
 CW 22 22 Sec. 30-22N-9  
 Reno County, Kansas

CONTRACTOR: PICKRELL DRILLING COMPANY, INC.  
 Wichita, Kansas

CASINO RECORD: 243' (9 jts.) 5 5/8" surface casing set at 243' in a 12 1/2" hole,  
 cemented with 150 sacks cement.

Drilled 7 7/8" hole from 243' to 3854' T.D. No oil string run.

LOG

(Figures indicate bottom formation - measurements from top rotary bushing.)

Sand	180	Circulate for samples at	3564'
Red Rock	248	" " " "	3678'
Shale & Red Bed	890	" " " "	3806'
Anhydrite	975	" " " "	3896'
Salt & Shale	1230	" " " "	3710'
Shale	1340	" " " "	3835'
Shale & Lime	2745		
Lime	3102		
Lime & Shale	3163	Slope test at	500' - 00' off.
Lime	3507	" " "	1000' - 00' off.
Lime, Shale & Chert	3557	" " "	1500' - 00' off.
Lime & Shale	3600	" " "	2500' - 00' off.
Lime	3750	" " "	3000' - 00' off.
Lime & Shale	3823	SEM at 3607'.	Correction
Lime	3854 Rotary T.D.	3607' = 3571	
		SEM at 3854 O.K.	

The undersigned, C. U. Gebits, Secretary of PICKRELL DRILLING COMPANY, INC., hereby certifies in behalf of said corporation, that the above log is a true and correct log of the formation encountered in drilling the above well as reflected by the Daily Drilling Reports.

PICKRELL DRILLING COMPANY, INC.  
 By *C. U. Gebits*  
 Secretary

STATE OF KANSAS )  
 ) CO  
 COUNTY OF SEDGWICK )

BE IT REMEMBERED that on this 24th day of January, 1950, before me, the undersigned, a Notary Public, duly commissioned, in and for the county and state aforesaid, came C. U. Gebits, Secretary of Pickrell Drilling Company, Inc., a corporation of the State of Kansas, personally known to me to be such officer, and to be the same person who executed on such officer the foregoing instrument of writing in behalf of said corporation, and he duly acknowledged the execution of the same for himself and for said corporation.

IN WITNESS WHEREOF, I have hereunto set my hand and official seal on this day and year last above written.

RECEIVED

*Ethel Zimmerman*  
 Notary Public

JAN 25 1950

My commission expires January 20, 1953.

PLUGGING ST.  
 FILE SEC 30 T 22 R 9 W  
 BOOK PAGE 34 LINE 41

REGISTRATION  
 COMMISSION  
 KANSAS