

WELL PLUGGING RECORD


STATE OF KANSAS  
STATE CORPORATION COMMISSION

Give All Information Completely  
Make Required Affidavit  
Mail or Deliver Report to:  
Conservation Division  
State Corporation Commission  
800 Bittling Building  
Wichita, Kansas

OR  
FORMATION PLUGGING RECORD

Strike out upper line  
when reporting plug-  
ging off formations.

NORTH

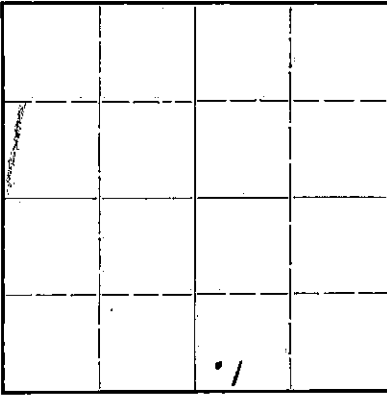

Locate well correctly on above  
Section Plat

Reno County. Sec. 30 Twp. 22S Rge. 9 (#) W (W)  
Location as "NE1/4NW1/4SW1/4" or footage from lines SW1/4 SW1/4 SE1/4  
Lease Owner. Texon Oil and Land Co.  
Lease Name. Frank E. Leslie Well No. 1  
Office Address. Box 1267, Ponca City, Oklahoma  
Character of Well (completed as Oil, Gas or Dry Hole) Oil Well  
Date well completed. August 13, 19 42  
Application for plugging filed. July 27, 19 45  
Application for plugging approved. August 6, 19 45  
Plugging commenced. August 1, 19 45  
Plugging completed. August 7, 19 45  
Reason for abandonment of well or producing formation. No longer a commercial  
producer  
If a producing well is abandoned, date of last production. July 14, 19 45  
Was permission obtained from the Conservation Division or its agents before plugging was com-  
menced? Yes

Name of Conservation Agent who supervised plugging of this well. Mr. H. W. Kerr, Great Bend, Kansas  
Producing formation. Viola Lime Depth to top. 3699' Bottom. 3703' Total Depth of Well. 3703 Feet  
Show depth and thickness of all water, oil and gas formations.

OIL, GAS OR WATER RECORDS


CASING RECORD

Formation	Content	From	To	Size	Put In	Pulled Out
	10 3/4" Surface casing				280'	None
	6" Oil string casing				3714' 4"	1597' 2"

Describe in detail the manner in which the well was plugged, indicating where the mud fluid was placed and the method or methods used in introducing it into the hold. If cement or other plugs were used, state the character of same and depth placed, from feet to feet for each plug set.

Hole was filled with heavy mud to 3687' where a wood plug was set and cemented with 6 sacks of cement; hole was then filled with heavy mud to within 270' of the top where a second wood plug was set and cemented with 20 sacks of cement; hole was then filled with heavy mud to within 15' of the top and capped with 5 sacks of cement.

PLUGGING  
FILE # 30 22S 9W  
BOOK PAGE 21 LINE 34

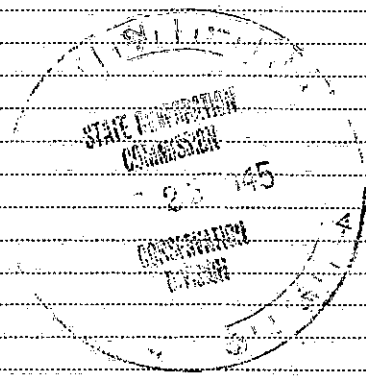

8-23-45

(If additional description is necessary, use BACK of this sheet)

Correspondence regarding this well should be addressed to. Mr. F. L. Dunn  
Address. R. F. D. #4, Lyons, Kansas

STATE OF Kansas, COUNTY OF Rice, ss.  
Mr. F. L. Dunn (employee of owner) or (owner or operator) of the above-described well,  
being first duly sworn on oath, says: That I have knowledge of the facts, statements, and matters herein contained and the log of the above-described well as filed and that the same are true and correct. So help me God.

(Signature) F. L. Dunn

R. F. D. #4, Lyons, Kansas  
(Address)

SUBSCRIBED AND SWORN to before me this 20th day of August, 19 45

Louis M. Gail  
Notary Public.

My commission expires 10-21-48

FLD-EHD  
8-20-45

LPC-1  
Corp. Comm.-1  
File-1