


STATE OF KANSAS
STATE CORPORATION COMMISSION
CONSERVATION DIVISION
P. O. BOX 17027
WICHITA, KANSAS 67217

FORM CP-4

WELL PLUGGING RECORD

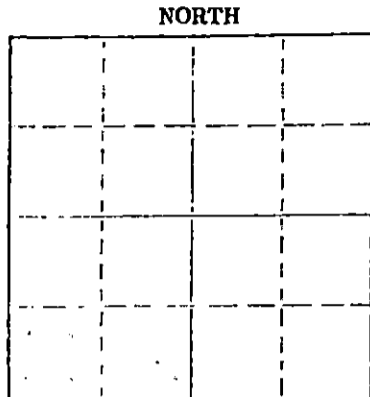

Locate well correctly on above Section Plat

Pawnee County, Sec. 10 Twp. 22 Rge. 15 (E) W (W)
Location as "NE/CNW/SW" or footage from lines NE/4 SW/4 SW/4
Lease Owner F & M Oil Co., Inc.
Lease Name COMPTON Well No. 1
Office Address NE SW SW R 603 Union Center Bldg, Wichita, Ks.
Character of Well (completed as Oil, Gas or Dry Hole) Dry Hole
Date well completed September 12 1974
Application for plugging filed September 12 1974
Application for plugging approved September 12 1974
Plugging commenced Sept. 12 1974
Plugging completed Sept. 12 1974
Reason for abandonment of well or producing formation _____

If a producing well is abandoned, date of last production _____ 19____
Was permission obtained from the Conservation Division or its agents before plugging was commenced? yes

Name of Conservation Agent who supervised plugging of this well Dale Balthazor
Producing formation _____ Depth to top _____ Bottom _____ Total Depth of Well 3965 Feet
Show depth and thickness of all water, oil and gas formations.

OIL, GAS OR WATER RECORDS				CASING RECORD		
FORMATION	CONTENT	FROM	TO	SIZE	PUT IN	PULLED OUT

Describe in detail the manner in which the well was plugged, indicating where the mud fluid was placed and the method or methods used in introducing it into the hole. If cement or other plugs were used, state the character of same and depth placed, from _____ feet to _____ feet for each plug set.

Squeezed hole with 100 sacks 50/50 Pozmix, with 6% Gel down 8-5/8" surface pipe.

RECEIVED
STATE CORPORATION COMMISSION
SEP 17 1974
CONSERVATION DIVISION
Wichita, Kansas

(If additional description is necessary, use BACK of this sheet)
Name of Plugging Contractor Duke Drilling Co.
Address Box 823 - Great Bend, Ks. 67530

STATE OF Kansas COUNTY OF Barton ss.
Leonard Williamson (employee of owner) or (PROPERTY OWNER) of the above-described

well, being first duly sworn on oath, says: That I have knowledge of the facts, statements, and matters herein contained and the log of the above-described well as filed and that the same are true and correct. So help me God.

(Signature) Leonard Williamson

Box 823 - Great Bend, Ks. 67530
(Address)

Subscribed and Sworn to before me this 16th day of September, 19 74

My Commission expires 4-11-1978

Veracity M. Hague
Notary Public.

DRILLERS WELL LOG

DATE COMMENCED: September 3, 1974
DATE COMPLETED: September 12, 1974

F & M OIL CO. Inc.
COMPTON #1
NE SW SW
Section 10, Twn. 22 S, Rge. 15 W
Pawnee County, Kansas

ELEVATION: 1991 K.B.

0 - 215'	Sand
215 - 331'	Shale
331 - 939'	Red Bed
939 - 965'	Anhydrite
965 - 1070'	Red Bed
1070 - 1870'	Shale - Shells
1870 - 3397'	Lime & Shale
3397 - 3401'	Shale
3401 - 3416'	Lime & Shale
3416 - 3430'	Lime
3430 - 3514'	Shale
3514 - 3524'	Lime & Shale
3524 - 3758'	Lime
3758 - 3867'	Lime - Shale - Chert
3867 - 3903'	Chert
3903 - 3954'	Shale - Sand
3954 - 3965'	Dolomite

FORMATION DATA

ANHYDRITE	939
HEBBER	3377
TORONTO	3416
DOUGLAS	3430
BROWN LIME	3514
KANSAS CITY	3524
BASE K.C.	3758
VIOLA	3867
SIMPSON	3903
AREUCKLE	3954
RED	3965

RECEIVED
STATE CORPORATION COMMISSION
SEP 17 1974
CONSERVATION DIVISION
Wichita, Kansas

SURFACE PIPE: Set 331' of
6-5/8", 28# with 275 sacks
of cement, 2 1/2 Gal, 3 1/2 cc.

AFFIDAVIT

STATE OF KANSAS
COUNTY OF BARTON,) ss.

Leonard Williamson of lawful age does swear and state that the facts and statements herein contained are true and correct to the best of his knowledge.

Leonard Williamson

Subscribed and sworn to before me this 16 day of September 1974.

My Comm. Expires:
April 11, 1978

Dorothy M. Hague
Notary Public