


WELL PLUGGING RECORD

Give All Information Completely  
Make Required Affidavit  
Mail or Deliver Report to:  
Conservation Division  
State Corporation Commission  
211 North Broadway  
Wichita, Kansas

NORTH

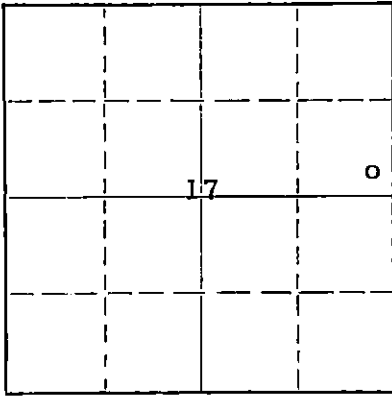

Locate well correctly on above  
Section Flat

Pawnee County. Sec. 17 Twp. 22 Rge. (E) 15W  
Location as "NE/CNW/SW" or footage from lines SE SE NE  
Lease Owner Murfin & Wilcox Oil Co.  
Lease Name Malin-Smith Well No. 1  
Office Address 507 Union Nat. Bank Bldg - Wichita, Kansas  
Character of Well (completed as Oil, Gas or Dry Hole) dry hole  
Date well completed 5-28 19 56  
Application for plugging filed 5-28 19 56  
Application for plugging approved 5-28 19 56  
Plugging commenced 5-28 19 56  
Plugging completed 5-28 19 56  
Reason for abandonment of well or producing formation dry

If a producing well is abandoned, date of last production 19  
Was permission obtained from the Conservation Division or its agents before plugging was commenced? yes

Name of Conservation Agent who supervised plugging of this well R. M. Brundege  
Producing formation \_\_\_\_\_ Depth to top \_\_\_\_\_ Bottom \_\_\_\_\_ Total Depth of Well 4022 Feet  
Show depth and thickness of all water, oil and gas formations.

OIL, GAS OR WATER RECORDS

CASING RECORD

FORMATION	CONTENT	FROM	TO	SIZE	PUT IN	PULLED OUT
				8 5/8	256	none

Describe in detail the manner in which the well was plugged, indicating where the mud fluid was placed and the method or methods used in introducing it into the hole. If cement or other plugs were used, state the character of same and depth placed, from \_\_\_\_\_ feet to \_\_\_\_\_ feet for each plug set.  
Filled hole with 80 sacks cement.

(If additional description is necessary, use BACK of this sheet)  
Name of Plugging Contractor Murfin Drilling Co.  
Address 507 Union Nat. Bank Bldg - Wichita, Kansas

STATE OF Kansas, COUNTY OF Sedgwick, ss.  
W. R. Murfin (employee of owner) or (owner or operator) of the above-described well, being first duly sworn on oath, says: That I have knowledge of the facts, statements, and matters herein contained and the log of the above-described well as filed and that the same are true and correct. So help me God.

(Signature) WR Murfin

(Address)

SUBSCRIBED AND SWORN to before me this 12th day of June, 1956.

My commission expires 6-13-59.

Betty Spriggs Notary Public.  
STATE OF KANSAS

PLUGGING  
FILE SEC 17 T 22 R 15W  
BOOK PAGE 66 LINE 12

JUN 15 1956  
6-16-56  
CONSERVATION DIVISION  
Wichita, Kansas

# WELL LOG

15-145-00119-0006

COMPANY **Murfin & Wilcox Oil Co.**

SEC. 17 T. 22S R. 15W

FARM **Malin-Smith** NO. 1

LOC. **SE SE NE**

TOTAL DEPTH **4022**

COMM. **5-15-56**


COMP. **5-28-56**

COUNTY **Pawnee**  
KANSAS

SHOT OR TREATED

CONTRACTOR **Murfin Drilling Co.**

ISSUED

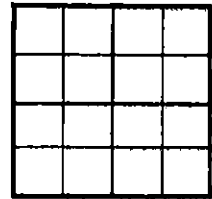

### CASING

20	10
15	8
12	6
13	5

**256' w/200 sx. cement**

ELEVATION **1991 DF**

PRODUCTION **D & A**

FIGURES INDICATE BOTTOM OF FORMATIONS

### Tops:

20	Shale	Anhydrite	960
195	Sand	Heebner	3409
256	Shale - Lime	Toronto	3426
325	Shale	Douglas	3444
360	Red Bed	Brown lime	3522
960	Shale - Red Bed	Lansing	3531
990	Anhydrite	BKC	3743
1270	Shale	Viola	3858
1675	Shale - Shells - Salt	Simpson shale	3931
3005	Shale - Lime	" sand	3950
3130	Lime	Arbuckle	3989
3305	Shale - Lime		
3735	Lime		
3805	Lime - Shale		
3932	Lime		
3965	Simpson		
3975	Shale		
3989	Shale - Lime		
4000	Arbuckle		
4022	Lime (Arb)		
4022	RTD		

REC'D  
STATE COURT

COMMISSIONER  
WELL

<b>PLUGGING</b>
FILE SEC. 17 T. 22 R. 15W
BOOK PAGE 66 LINE 12

State of Kansas }  
County of Sedgwick } ss:

I, W. R. Murfin of the Murfin Drilling Company

upon oath state that the above and foregoing is a true and correct copy of the log of the Malin-Smith #1 well.

W. R. Murfin

Subscribed and sworn to before me this 12th day of June 1956.

My Commission Expires: 6-13-59.

Betty Spriggs  
NOTARY PUBLIC