


WELL PLUGGING RECORD

Give All Information Completely  
Make Required Affidavit  
Mail or Deliver Report to:  
Conservation Division  
State Corporation Commission  
800 Bittling Building  
Wichita, Kansas

Pawnee County. Sec. 17 Twp. 22 Rge. (E) 15 (W)

Location as "NE/CNW/SW" or footage from lines SW SW SE  
Lease Owner Musgrove Petroleum Corporation  
Lease Name SMITH C Well No. 1  
Office Address 518 Petroleum Building, Wichita, Kansas.  
Character of Well (completed as Oil, Gas or Dry Hole) Dry hole  
Date well completed September 17, 19 54  
Application for plugging filed verbally September 17, 19 54  
Application for plugging approved verbally September 17, 19 54  
Plugging commenced September 17, 19 54  
Plugging completed September 17, 19 54  
Reason for abandonment of well or producing formation Dry hole

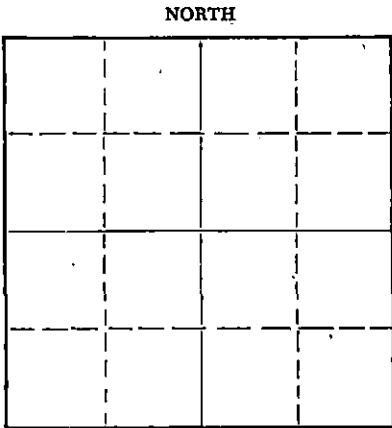

Locate well correctly on above Section Plat

If a producing well is abandoned, date of last production 19  
Was permission obtained from the Conservation Division or its agents before plugging was commenced? verbally - yes

Name of Conservation Agent who supervised plugging of this well \_\_\_\_\_  
Producing formation \_\_\_\_\_ Depth to top \_\_\_\_\_ Bottom \_\_\_\_\_ Total Depth of Well 4065 Feet  
Show depth and thickness of all water, oil and gas formations.

OIL, GAS OR WATER RECORDS

CASING RECORD

FORMATION	CONTENT	FROM	TO	SIZE	PUT IN	PULLED OUT
				8-5/8"	856'	

Describe in detail the manner in which the well was plugged, indicating where the mud fluid was placed and the method or methods used in introducing it into the hole. If cement or other plugs were used, state the character of same and depth placed, from \_\_\_\_\_ feet to \_\_\_\_\_ feet for each plug set.

Filled hole with mud to 300'.  
Set first plug at 300' with 1/2 sack hulls & 15 sx cement.  
Filled hole with mud to 40'.  
Set 2nd plug at 40' with 1/2 sack hulls & 10 sx cement.

(If additional description is necessary, use BACK of this sheet)  
Name of Plugging Contractor MUSGROVE PETROLEUM CORPORATION  
Address 518 Petroleum Building, Wichita, Kansas.

STATE OF Kansas, COUNTY OF Sedgwick, ss.  
I, Gordon J. Koelling (employee of owner) or (owner or operator) of the above-described well, being first duly sworn on oath, says: That I have knowledge of the facts, statements, and matters herein contained and the log of the above-described well as filed and that the same are true and correct. So help me God.

(Signature) Gordon J. Koelling  
518 Petroleum Building, Wichita, Kansas.  
(Address)

SUBSCRIBED AND SWORN TO before me this 20th day of September, 19 54

My commission expires June 16, 1955.

Alma E. Rose  
Notary Public.

**PLUGGING**  
FILE SEC 12 T-22 R-15W  
BOOK PAGE 64 LINE 32

CONSERVATION DIVISION  
Wichita, Kansas

9-22-54

CONTRACTOR'S WELL LOG

COMPANY:	Musgrove Petroleum Corporation
CONTRACTOR:	Musgrove Petroleum Corporation
FARM:	Smith C #1
LOCATION:	SW SW SE, Section 17-22-15, Pawnee County, Kans.
COMMENCED:	September 8, 1954
COMPLETED:	September 17, 1954

0	15	Clay
15	65	Sand & shale
65	180	Sand
180	422	Shale
422	490	Sand
490	600	Sand & shale
600	775	Shale
775	850	Red bed & shale
850	945	Red bed
945	995	Anhydrite
995	1750	Shale & shells
1750	3544	Lime & shale
3544	3617	Lime
3617	3695	Shale & lime
3695	3755	Lime
3755	3808	Lime & shale
3808	3881	Lime
3881	3900	Chert & lime
3900	3932	Lime & chert
3932	3982	Shale & lime
3982	4010	Chert, Lime & shale
4010	4029	Shale, chert & sand
4029	4065	Arbuckle
	4065	Rotary Total Depth

Set 8-5/8" surface pipe at 856' with 550 sacks cement, 2% calcium chloride  
Dry and Abandoned.

STATE OF KANSAS )  
                          ) SS  
COUNTY OF SEDGWICK )

I, GORDON L. KOELLING, do hereby certify that the above and foregoing is a true and correct copy of the log of the SMITH C #1, SW SW SE, Section 17-22-15, Pawnee County, Kansas, as reflected by the records of the Musgrove Petroleum Corporation.

MUSGROVE PETROLEUM CORPORATION

By Gordon L. Koelling  
Secretary-Treasurer

Subscribed and sworn to before me, a Notary Public, in and for Sedgwick County, Kansas, this 20th day of September, 1954.

Ernest E. Rane  
Notary Public

My commission expires July 16, 1955.

**PLUGGING**  
FILE SEC. 17-22-R/50  
BOOK PAGE 64 LINE 37

CONSERVATION DIVISION  
