

STATE OF KANSAS
STATE CORPORATION COMMISSION


WELL PLUGGING RECORD

Give All Information Completely
Make Required Affidavit
Mail or Deliver Report to:
Conservation Division
State Corporation Commission
800 Biting Building
Wichita, Kansas

Pawnee County, Sec. 26 Twp 22S Rge. (E) 15 (W)

Location as "NE/CNWxSWx" or footage from lines SW SE NE
Lease Owner Natural Gas and Oil Company, etal
Lease Name E. D. Crane Well No. 1
Office Address 1009 Central Building, Wichita, Kansas
Character of Well (completed as Oil, Gas or Dry Hole) dry hole
Date well completed July 2, 1954 19
Application for plugging filed July 2, 1954 (orally) 19
Application for plugging approved July 2, 1954 (Orally) 19
Plugging commenced July 2, 1954 19
Plugging completed July 2, 1954 19
Reason for abandonment of well or producing formation

NORTH

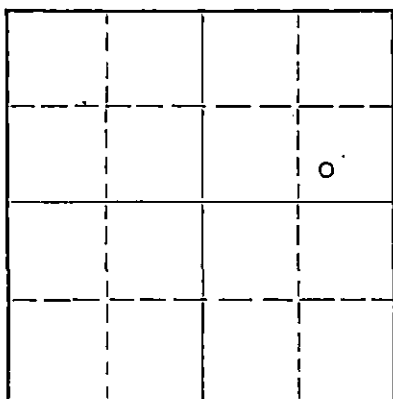

Locate well correctly on above
Section Plat

If a producing well is abandoned, date of last production 19
Was permission obtained from the Conservation Division or its agents before plugging was commenced? yes

Name of Conservation Agent who supervised plugging of this well M. A. Rives, Pratt, Kansas
Producing formation Depth to top Bottom Total Depth of Well Feet
Show depth and thickness of all water, oil and gas formations.

OIL, GAS OR WATER RECORDS

CASING RECORD

FORMATION	CONTENT	FROM	TO	SIZE	PUT IN	PULLED OUT
surface		0	196	8 5/8"	196	none

Describe in detail the manner in which the well was plugged, indicating where the mud fluid was placed and the method or methods used in introducing it into the hole. If cement or other plugs were used, state the character of same and depth placed, from feet to feet for each plug set.

Filled hole with heavy mud from 4075 T. D. to 190 feet
Set plug at 190 feet and ran 20 sacks cement to 140 feet
Filled with heavy mud from 140 feet to 35 feet
Set plug at 35 feet and capped with 10 sacks cement.

7-9-54

(If additional description is necessary, use BACK of this sheet)
Name of Plugging Contractor Drilling Department of Natural Gas and Oil Company, a division
Address of Mississippi River Fuel Corporation, Route #1, Great Bend, Kansas

STATE OF Kansas, COUNTY OF Sedgwick, ss.
John D. Carey (employee of owner) of the above-described well, being first duly sworn on oath, says: That I have knowledge of the facts, statements, and matters herein contained and the log of the above-described well as filed and that the same are true and correct. So help me God.

(Signature) John D. Carey
1009 Central Building, Wichita, Ks
(Address)

SUBSCRIBED AND SWORN to before me this 6th day of July 1954

Ester Small
Notary Public.

My commission expires May 25, 1957

PLUGGING
FILE SEC 26 T 22 R 15W
BOOK PAGE 46 LINE 16

DRILLER'S LOG

COMPANY: Natural Gas and Oil Company, a division of
Mississippi River Fuel Corporation, etal

CONTRACTION: Drilling Department of Natural Gas & Oil Company

FARM: E. D. Crane #1, SW SE NE Sec. 26-22S-15W
Pawnee County, Kansas

COMMENCED: June 21, 1954

COMPLETED: June 2, 1954

ELEVATION: 1985 RB.

0	to	25	Clay
25	to	100	Sand
100	to	385	Shale and shells
385	to	475	Sand
475	to	930	Red bed, shale
930	to	960	Anhydrite
960	to	1425	Shale and shells
1425	to	1575	Salt, shale and shells
1575	to	2860	Shale and lime
2860	to	2880	Shale
2880	to	3285	Lime and shale
3285	to	3220	Lime
3320	to	3335	Shale
3335	to	3550	Shale and lime
3550	to	3785	Lime
3785	to	3838	Lime and shale
3838	to	3880	Lime, shale and chert
3880	to	3887	Lime
3887	to	3926	Lime and chert
3926	to	3976	Lime-shale-chert
3976	to	4015	Lime, shale and sand
4015	to	4040	Lime and shale
4040	to	4075	Arbuckle lime
		4075	T. D.

Set 196 feet 8 5/8" 24# surface pipe. Cemented with
225 sacks cement and 4 sacks calcium chloride.

TOPS:	Anhydrite	930	Lansing	3552	Simpson	3976
	Heebner	3416	Base KC	3775	Arbuckle	4034
	Brn Lime	3543	Viola	3887		

No DSTs. Ran Schlumberger
DRY, PLUGGED AND ABANDONED

JUL 9 - 1954
CONSERVATION DIVISION -
Wichita, Kansas

C E R T I F I C A T E

I, John D. Carey, do hereby certify that the above and
foregoing is a true and correct copy of the log of the
E. D. Crane #1, SW SE NE Section 26-22S-15W, Pawnee County,
Kansas, as reflected by files of the Natural Gas and Oil
Company, a division of Mississippi River Fuel Corporation.

John D. Carey
John D. Carey
Exploration and Land Manager

Subscribed and sworn to before me, a Notary Public, within
and for Sedgwick County, Kansas, this 6th Day of July, 1954.

Esther Unsell
Esther Unsell, Notary Public

My commission expires May 25, 1957.

