


WELL PLUGGING RECORD

Give All Information Completely
Make Required Affidavit
Mail or Deliver Report to:
Conservation Division
State Corporation Commission
800 Bitting Building
Wichita, Kansas

NORTH

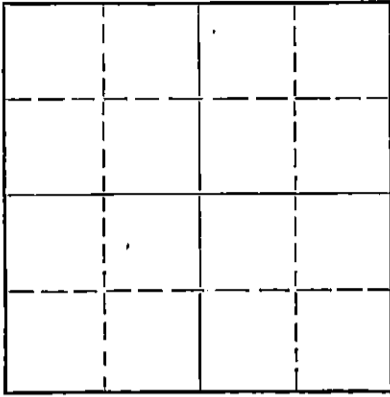

Locate well correctly on above
Section Plat

Kingman County. Sec. 28 Twp. 30 Rge. 10 (E) (W)
Location as "NE/CNW/SW" or footage from lines C W/2 SW SW
Lease Owner Musgrove Petroleum Corporation
Lease Name Allen Well No. 1-B
Office Address 518 Petroleum Building, Wichita, Kansas.
Character of Well (completed as Oil, Gas or Dry Hole) Dry Hole
Date well completed July 26, 19 53
Application for plugging filed July 26, 19 53
Application for plugging approved 19
Plugging commenced July 26, 19 53
Plugging completed July 26, 19 53
Reason for abandonment of well or producing formation Dry Hole

If a producing well is abandoned, date of last production 19
Was permission obtained from the Conservation Division or its agents before plugging was commenced? Yes- verbal

Name of Conservation Agent who supervised plugging of this well
Producing formation Depth to top Bottom Total Depth of Well 4870 Feet
Show depth and thickness of all water, oil and gas formations.

OIL, GAS OR WATER RECORDS

CASING RECORD

FORMATION	CONTENT	FROM	TO	SIZE	PUT IN	PULLED OUT
				8-5/8"	285'	

Describe in detail the manner in which the well was plugged, indicating where the mud fluid was placed and the method or methods used in introducing it into the hole. If cement or other plugs were used, state the character of same and depth placed, from feet to feet for each plug set.

Set bottom plug at 270 feet with 20 sacks cement
Set top plug at 40' with 10 sacks cement

(If additional description is necessary, use BACK of this sheet)
Name of Plugging Contractor Musgrove Petroleum Corporation
Address 518 Petroleum Building, Wichita, Kansas.


STATE OF Kansas, COUNTY OF Sedgwick, ss.
I, Gordon L. Koelling (employee of owner) or (owner/operator) of the above-described well, being first duly sworn on oath, says: That I have knowledge of the facts, statements, and matters herein contained and the log of the above-described well as filed and that the same are true and correct. So help me God.

(Signature) *Gordon L. Koelling*
518 Petroleum Building, Wichita, Kansas.
(Address)

SUBSCRIBED AND SWORN TO before me this 6th day of August, 1953

My commission expires September 24, 1956

Thomas L. Stumpe
RECEIVED
Notary Public.

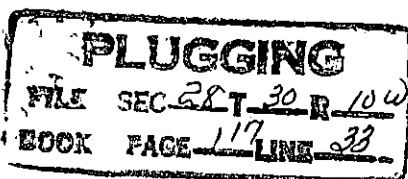

8-7-1956

CONTRACTOR'S WELL LOG

COMPANY:	Musgrove Petroleum Corporation
CONTRACTOR:	Musgrove Petroleum Corporation
FARM:	ALLEN #1-B
LOCATION:	C W/2 SW SW Section 28-30-10 Kingman County, Kansas.
COMMENCED:	July 2, 1953
COMPLETED:	July 26, 1953

0	140	Surface clay and sand
140	550	Red Bed
550	881	Red bed & shald
881	1326	Shale
1326	1363	Anhydrite
1363	1590	Shale & shells
1590	1735	Lime & shells
1735	1948	Shale, lime and shells
1948	3096	Lime & shale
3096	3223	Lime
3223	3775	Lime & shale
3775	3806	Sand
3806	3860	Lime
3860	3994	Lime & shale
3994	4241	Lime
4241	4430	Lime & shale
4430	4445	Mississippi
4445	4473	Mississippi lime & chat
4473	4524	Mississippi
4524	4668	Lime and shale
4668	4703	Lime
4703	4718	Viola lime
4718	4729	Viola & sand
4729	4737	Core
4737	4769	Shale & sand
4769	4796	Shale & sand streaks
4796	4813	Shale & sand
4813	4840	Shale
4840	4870	Arbuckle
	4870	Rotary Total Depth

Set 8-5/8" surface casing at 285' with 225 sacks of cement.
 Dry and abandoned

STATE OF KANSAS)
) SS
 COUNTY OF SEDGWICK)

I, GORDON L. KOELLING, do hereby certify that the above and foregoing is a true and correct copy of the log of the ALLEN #1-B Center W/2 SW SW, Section 28-30-10, Kingman County, Kansas, as reflected by the files of the Musgrove Petroleum Corporation.

MUSGROVE PETROLEUM CORPORATION

BY Gordon L. Koelling
 Secretary-Treasurer

Subscribed and sworn to before me, a Notary Public, in and for Sedgwick County, Kansas, this 6th day of August, 1953.

Alvin L. Thompson
 Notary Public

My commission expires September 24, 1956.

