


WELL PLUGGING RECORD

Give All Information Completely
Make Required Affidavit
Mail or Deliver Report to:
Conservation Division
State Corporation Commission
86 Westinghouse Building
Wichita, Kansas

NORTH

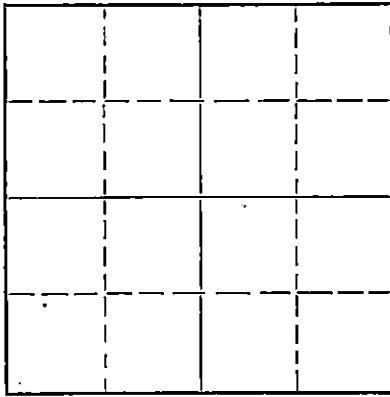

Locate well correctly on above
Section Plat

Kingman County. Sec. 28 Twp. 30 Rge. 10 (E) (W)
Location as "NE/CNW/SW" or footage from lines C W/2 SW SW
Lease Owner Musgrove Petroleum Corporation
Lease Name ALLEN Well No. 1
Office Address 518 Petroleum Building, Wichita, Kansas.
Character of Well (completed as Oil, Gas or Dry Hole) lost hole, skidded rig
Date well completed July 1 19 53
Application for plugging filed July 1 verbally 19 53
Application for plugging approved verbally on July 1 19 53
Plugging commenced July 1, 19 53
Plugging completed July 1, 19 53
Reason for abandonment of well or producing formation lost hole, skidded rig

If a producing well is abandoned, date of last production 19
Was permission obtained from the Conservation Division or its agents before plugging was commenced? yes

Name of Conservation Agent who supervised plugging of this well
Producing formation none Depth to top Bottom Total Depth of Well 3487 1/2 Feet
Show depth and thickness of all water, oil and gas formations.

OIL, GAS OR WATER RECORDS

CASING RECORD

FORMATION	CONTENT	FROM	TO	SIZE	PUT IN	PULLED OUT
				8-5/8"	275'	none

Describe in detail the manner in which the well was plugged, indicating where the mud fluid was placed and the method or methods used in introducing it into the hole. If cement or other plugs were used, state the character of same and depth placed, from feet to feet for each plug set.
Set a wooden plug at 300'. Pumped in 125 sacks cement with Halliburton filling hole from 300' to top of ground.

Handwritten notes:
out of 700
20' at 200'
mud set
10' at 40'

(If additional description is necessary, use BACK of this sheet)

Name of Plugging Contractor Halliburton Oil Well Cementing Company
Address Union National Bank Building, Wichita, Kansas.

STATE OF Kansas, COUNTY OF Sedgwick, ss.
Gordon L. Koelling, (employee of owner) or (owner) or (operator) of the above-described well, being first duly sworn on oath, says: That I have knowledge of the facts, statements, and matters herein contained and the log of the above-described well as filed and that the same are true and correct. So help me God.

(Signature) *Gordon L. Koelling*
518 Petroleum Building, Wichita, Kansas.
(Address)

SUBSCRIBED AND SWORN TO before me this 2nd day of July 19 53

Thelma P. Lancaster
Notary Public.

My commission expires 9-24-56

PLUGGING
FILE SEC 28 T 30 R 10W
BOOK PAGE 112 LINE 8

STATE CORPORATION COMMISSION
JUL 3 1953 7-3-53
CONSERVATION DIVISION
Wichita, Kansas

CONTRACTOR'S WELL LOG

COMPANY: Musgrove Petroleum Corporation
 CONTRACTOR: Musgrove Petroleum Corporation
 FARM: Allen #1
 LOCATION: C W/2 SW SW, Section 28-30-10
 Kingman County, Kansas.
 COMMENCED: June 19, 1953
 COMPLETED: July 1, 1953

0	275	Sand and gravel
275	560	Red bed
560	1254	Red bed & shale
1254	1340	Shale
1340	1380	Anhydrite
1380	1550	Shale
1550	3475	Lime & shale
3475	3487 1/2	Lime, shale & iron

Set 275' of 8-5/8" surface pipe with 125 sacks of cement.

Surface pipe parted at second joint -- skidded rig.

STATE OF KANSAS)
) SS
 COUNTY OF SEDGWICK)

I, GORDON L. KOELLING, do hereby certify that the above and foregoing is a true and correct copy of the log of the Allen #1, C W/2 SW SW, Section 28-30-10, Kingman County, Kansas, as reflected by the files of the Musgrove Petroleum Corporation.

MUSGROVE PETROLEUM CORPORATION
Gordon L. Koelling
 Secretary-Treasurer

Subscribed and sworn to before me, a Notary Public, in and for Sedgwick County, Kansas, this 10th day of July, 1953.

Richard Stump
 Notary Public

My commission expires September 24, 1956.

PLUGGING
 FILE SEC 28 T 30 R 100
 BOOK PAGE 112 LINE 6

RECEIVED
 STATE CORPORATION COMMISSION
 JUL 24 1953
 CONSERVATION DIVISION
 Wichita, Kansas