


Give All Information Completely
Make Required Affidavit
Mail or Deliver Report to:
Conservation Division
State Corporation Commission
212 North Market, Insurance Bldg.
Wichita, Kansas

WELL PLUGGING RECORD

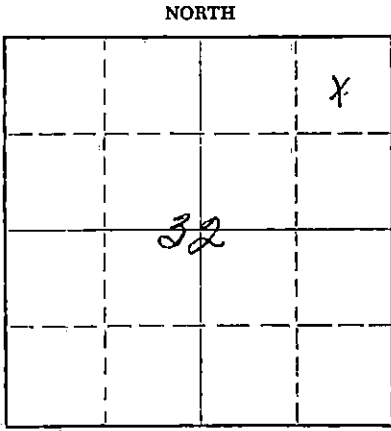

Locate well correctly on above Section Plat

Stafford County. Sec 32 Twp 22^S Rge 13 (KX) (W)
Location as "NE/CNW&SWK" or footage from lines NE NE NE
Lease Owner WILKINSON DRILLING, INC.
Lease Name Milton Well No. 1
Office Address 805 Union Center Bldg., Wichita 2, Kansas
Character of Well (completed as Oil, Gas or Dry Hole) Dry Hole
Date well completed January 31, 19 60
Application for plugging filed January 31, 19 60
Application for plugging approved January 31, 19 60
Plugging commenced January 31, 19 60
Plugging completed February 1, 19 60
Reason for abandonment of well or producing formation Dry Hole

If a producing well is abandoned, date of last production _____ 19 ____
Was permission obtained from the Conservation Division or its agents before plugging was commenced? yes

Name of Conservation Agent who supervised plugging of this well Frank Broadfoot
Producing formation _____ Depth to top _____ Bottom _____ Total Depth of Well 3880 Feet
Show depth and thickness of all water, oil and gas formations.

OIL, GAS OR WATER RECORDS

CASING RECORD

FORMATION	CONTENT	FROM	TO	SIZE	PUT IN	PULLED OUT
Sand	Water	30	85			

Describe in detail the manner in which the well was plugged, indicating where the mud fluid was placed and the method or methods used in introducing it into the hole. If cement or other plugs were used, state the character of same and depth placed, from _____ feet to _____ feet for each plug set.

Fill hole with heavy mud, plug, 1/3 sack hulls @240', topped with 20 sacks cement through drill pipe. Mud to 35', plug and 1/3 sack hulls top with 10 sacks cement through drill pipe.

RECEIVED
STATE CORPORATION COMMISSION

FEB 11 1960

CONSERVATION DIVISION
Wichita, Kansas

2-11-60

(If additional description is necessary, use BACK of this sheet)

Name of Plugging Contractor WILKINSON DRILLING, INC.
Address 805 Union Center Building, Wichita 2, Kansas

STATE OF Kansas, COUNTY OF Sedgwick, ss.
Walter M. Wilkinson (Employer or owner) or (owner or operator) of the above-described well, being first duly sworn on oath, says: That I have knowledge of the facts, statements, and matters herein contained and the log of the above-described well as filed and that the same are true and correct. So help me God.

(Signature) Walter M. Wilkinson

805 Union Center Bldg. Wichita 2, Ks.
(Address)

SUBSCRIBED AND SWORN TO before me this 5 day of February, 19 60

My commission expires January 2, 1961

Carolyn K. Moore
Carolyn K. Moore Notary Public.



WILKINSON DRILLING, INC.
805 Union Center Building
Wichita 2, Kansas

February 5, 1960

MILTON #1

Company - WILKINSON DRILLING, INC.
Contractor - Company Tools
Commenced - January 22, 1960
Completed - January 31, 1960
Total Depth - 3880'
Location - NE NE NE, Sec. 32-22^S-13^W,
Stafford County, Kansas
Elevation - 1905 Ground Level
Casing - 8 5/8" @ 252' with 200 sacks

RECEIVED
STATE CORPORATION COMMISSION

FEB 11 1960

CONSERVATION DIVISION
Wichita, Kansas

FIGURES INDICATE BOTTOMS OF FORMATIONS

<u>Depth</u>	<u>Formations</u>
0 - 145	Surface soil and sand.
145 - 1650	Shale and shells.
1650 - 3297	Lime and shale.
3297 - 3304	Shale.
3304 - 3320	Lime and shale.
3320 - 3337	Lime.
3337 - 3430	Shale and sandy shale.
3430 - 3736	Lime and shale streaks.
3736 - 3839	Chert and cherty lime.
3839 - 3846	Shale.
3846 - 3856	Sand.
3856 - 3880	Shale.

We hereby certify the above and foregoing to be a true and correct copy of the Log on the MILTON #1, located in the NE NE NE, Sec. 32-22^S-13^W, Stafford County, Kansas.

WILKINSON DRILLING, INC.

Walter M. Wilkinson

Subscribed and sworn to before me this fifth day of February, nineteen hundred and sixty.

Carolyn K. Moore

My commission expires January 2, 1961.