

This form shall be filed in duplicate with the Kansas Corporation Commission, 200 Colorado Derby Building, Wichita, Kansas 67202, within ten days after the completion of the well, regardless of how the well was completed.

Attach separate letter of request if the information is to be held confidential. If confidential, only file one copy. Information on side one will be of public record and side two will then be held confidential.

Circle one: Oil Gas, Dry, SWD, OWWO, Injection. Type and complete ALL sections. Applications must be filed for dual completion, commingling, SWD and injection, T.A.

Attach wireline logs (i.e. electrical log, sonic log, gamma ray neutron log, etc.). KCC # (316) 263-3238. (Rules 82-2-105 & 82-2-125)

OPERATOR Dakota Resources, Inc.
ADDRESS 2900 Security Life Building
Denver, Colorado 80202

API NO. 15-185-21,500-0000
COUNTY Stafford

**CONTACT PERSON D. M. Erickson
PHONE 303-825-2900

FIELD CLARKSBURG SEW.C
PROD. FORMATION Lansing

PURCHASER Conoco
ADDRESS P. O. Box 1267
Ponca City, OK 74603


LEASE LEWIS
WELL NO. 1
WELL LOCATION SW SW SW

DRILLING Allen Drilling Company
CONTRACTOR ADDRESS P.O. Box 1389
Great Bend, KS 67530

330 Ft. from West Line and
_____ Ft. from _____ Line of
the SEC. 31 TWP. 22 RGE. 12 W

PLUGGING _____
CONTRACTOR ADDRESS _____

WELL PLAT

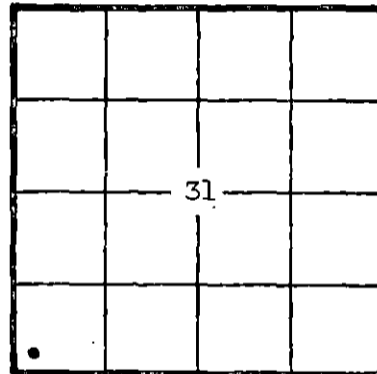

KCC
KGS
(Office Use)

TOTAL DEPTH 3845' PBTD _____

SPUD DATE 3/02/82 DATE COMPLETED 3/08/82

ELEV: GR 1856' DF 1858' KB 1861'

DRILLED WITH ~~(CABLE)~~ (ROTARY) ~~(AIR)~~ TOOLS

Amount of surface pipe set and cemented 259 DV Tool Used? _____

AFFIDAVIT

STATE OF COLORADO, COUNTY OF Denver SS, I, _____

D. M. Erickson OF LAWFUL AGE, BEING FIRST DULY SWORN UPON HIS OATH,
DEPOSES THAT HE IS Manager of Operations (FOR) (OF) DAKOTA RESOURCES, INC.

OPERATOR OF THE LEWIS LEASE, AND IS DULY AUTHORIZED TO MAKE
THIS AFFIDAVIT FOR AND ON THE BEHALF OF SAID OPERATOR, THAT WELL NO. 1 ON
SAID LEASE HAS BEEN COMPLETED AS OF THE 1 DAY OF APRIL, 1982, AND THAT
ALL INFORMATION ENTERED HEREIN WITH RESPECT TO SAID WELL IS TRUE AND CORRECT.

FURTHER AFFIANT SAITH NOT.

SUBSCRIBED AND SWORN BEFORE ME THIS 19th DAY OF August, 1982.

(S) [Signature]
Jane Espino

MY COMMISSION EXPIRES: November 13, 1982.

NOTARY PUBLIC RECEIVED 4-23-82
STATE CORPORATION COMMISSION
CONSERVATION DIVISION
Wichita, Kansas

**The person who can be reached by phone regarding any questions concerning this information. Within 45 days of completion, a witnessed initial test by the Commission required if the well produces more than 25 BOPD or is located in a Basic Oil Pool.

SIDE TWO

WELL LOG

Show all important zones of porosity and contents thereof; cored intervals, and all drill-stem tests, including depth interval tested, cushion used, time tool open, flowing and shut-in pressures, and recoveries.

SHOW GEOLOGICAL MARKERS, LOGS RUN, OR OTHER DESCRIPTIVE INFORMATION.

FORMATION DESCRIPTION; CONTENTS, ETC.	TOP	BOTTOM	NAME	DEPTH
			Heebner	3212
			Toronto	3230
			Douglas	3246
			Brown Lime	3351
			Lansing	3371
			Base/KC	3610
			Conglomerate	3644
			Viola	3684
			Simpson Shale	3737
			Simpson Sand	3761
			Arbuckle	3794

Report of all strings set—surface, intermediate, production, etc. **CASING RECORD** (New) or (Used)

Purpose of string	Size hole drilled	Size casing set (in O.D.)	Weight lbs/ft.	Setting depth	Type cement	Sacks	Type and percent additives
Surface	12 1/4"	8-5/8"	20#	@ 259'	60/40 poz.	250	2% gel, 3% cc
production	7-7/8"	4-1/2"		@ 3845'	50/50 poz	150	1% salt .75% 1% CFR2

LINER RECORD

PERFORATION RECORD

Top, ft.	Bottom, ft.	Sacks cement	Shots per ft.	Size & type	Depth interval
			2	JSPF	3502-08

TUBING RECORD

Size	Setting depth	Packer set at
2 3/8	3766	

ACID, FRACTURE, SHOT, CEMENT SQUEEZE RECORD

Amount and kind of material used	Depth interval treated
2000 gal. 15% HCl	3502-08

Date of first production	Producing method (flowing, pumping, gas lift, etc.)	Gravity
April 1, 1982	Pumping	
RATE OF PRODUCTION PER 24 HOURS	Oil 1 bbls. Gas TSTM MCF Water % 3 bbls. Gas-oil ratio CFPB	
Disposition of gas (vented, used on lease or sold)		Perforations 3502-08
Used on lease		