

STATE OF KANSAS
STATE CORPORATION COMMISSION

Give All Information Completely
Make Required Affidavit
Mail or Deliver Report to:
Conservation Division
State Corporation Commission
214 So. Broadway
Wichita, Kansas

WELL PLUGGING RECORD

Stafford County, Sec. 35 Twp. 22 Rge. (E) 14 (W)

Location as "NE/CNW%SW%" or footage from lines NW SW SW

Lease Owner Chief Drilling Co., Inc.

Lease Name Ratts Well No. 1

Office Address Post Office Box 97, Great Bend, Kansas

Character of Well (completed as Oil, Gas or Dry Hole) Dry Hole

Date well completed 9-30-60 19

Application for plugging filed 9-30-60 19

Application for plugging approved 9-30-60 19


Plugging commenced 9-30-60 19

Plugging completed 9-30-60 19

Reason for abandonment of well or producing formation Dry Hole

If a producing well is abandoned, date of last production _____ 19

Was permission obtained from the Conservation Division or its agents before plugging was commenced? Yes

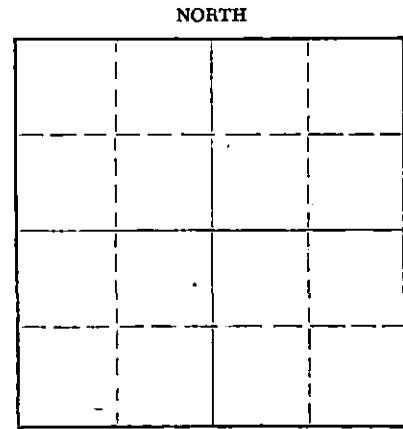

Locate well correctly on above Section Plat

Name of Conservation Agent who supervised plugging of this well W. L. Lackamp, Stafford, Kansas

Producing formation _____ Depth to top _____ Bottom _____ Total Depth of Well 3915 Feet

Show depth and thickness of all water, oil and gas formations.

OIL, GAS OR WATER RECORDS

CASING RECORD

FORMATION	CONTENT	FROM	TO	SIZE	PUT IN	PULLED OUT
				8 5/8"	256'	NONE

Describe in detail the manner in which the well was plugged, indicating where the mud fluid was placed and the method or methods used in introducing it into the hole. If cement or other plugs were used, state the character of same and depth placed, from _____ feet to _____ feet for each plug set.

1/3 sack of hulls, wooden plug set at 240 ft.
Mixed 20 sacks cement through drill pipe.

1/3 sack of hulls, wooden plug set at 35 ft.
Mixed 10 sacks cement.

10-1-60

RECEIVED
STATE CORPORATION COMMISSION

OCT 1 1960

CONSERVATION DIVISION
Wichita, Kansas

(If additional description is necessary, use BACK of this sheet)

Name of Plugging Contractor Chief Drilling Co., Inc.

Address Post Office Box 97, Great Bend, Kansas

STATE OF KANSAS COUNTY OF BAFTON, ss.

V. Richard Hoover, President (employee of owner) or (owner or operator) of the above-described well, being first duly sworn on oath, says: That I have knowledge of the facts, statements, and matters herein contained and the log of the above-described well as filed and that the same are true and correct. So help me God.

(Signature) V. Richard Hoover

(Address)

SUBSCRIBED AND SWORN TO before me this 30th day of September, 19 60

Norris Taylor
Notary Public.

My commission expires May 19, 1962

WELL LOG

Chief Drilling Co., Inc.
P.O. Box 97
Great Bend, Kansas

#1 Ratts
NW SW SW Sec. 35-22S-14W
Stafford County, Kansas

Contractor: Chief Drilling Co., Inc.

Commenced: 9-20-60
Completed: 9-30-60
D&A

Casing Record: 8 5/8" at 256' with 200 sacks sunset cement

<u>FORMATION</u>	<u>From</u>	<u>To</u>	<u>ELEVATION</u>
Shale & Sand	0	255'	1935' Gr.
Red Shale	255'	300'	1937' D.F.
Sand	300'	375'	1940' K.B.
Shale	375'	847'	
Anhydrite	847'	870'	
Shale	870'	990'	
Shale & Shells	990'	1700'	
Lime with shale streaks	1700'	1825'	
Lime	1825'	2180'	
Shale & Lime	2180'	2875'	
Lime & Shale	2875'	3175'	
Lime	3175'	3345'	
Shale with Lime	3345'	3475'	
Lime	3475'	3713'	
Shale & Lime	3713'	3782'	
Chert	3782'	3852'	
Shale	3852'	3903'	
Dolomite	3903'	3915'	
Total Depth	3915'		

<u>FORMATION TOPS</u>	
Anhydrite	847' (+1093)
Heebner	3345' (-1405)
Brn Lime	3475' (-1535)
Lansing	3487' (-1547)
Kansas City	3713' (-1773)
Viola	3782' (-1842)
Simpson	3852' (-1912)
Arbuckle	3903' (-1963)
Total Depth	3915' (-1975)

STATE OF KANSAS, COUNTY OF BARTON) SS

I hereby certify that the above is a true and correct copy of the Driller's Log of the well drilled in the NW SW SW Sec. 35-22S-14W, Stafford County, Kansas to the best of my knowledge and belief.

CHIEF DRILLING CO., INC.

Richard Hoover

V. Richard Hoover, President

Subscribed and sworn to before me this 30th day of September, 1960.

My commission expires 5/19/62

Norris Taylor

Norris Taylor, Notary Public

00031 19680

CONSERVATION DIVISION
Wichita, Kansas