


WELL PLUGGING RECORD

Give All Information Completely
Make Required Affidavit
Mail or Deliver Report to:
Conservation Division
State Corporation Commission
390 Bittling Building
Wichita, Kansas

NORTH

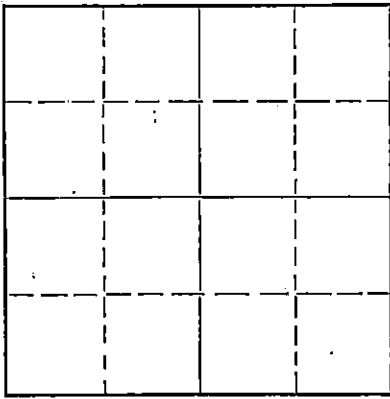

Locate well correctly on above
Section Plat

Stafford County. Sec. 35 Twp. 22 Rge. 14 (E) W (W)
Location as "NE/CNW/SW" or footage from lines. SE SE NW
Lease Owner Greenland Drig. Co., et al
Lease Name Ratts Well No. 1
Office Address 506 Union Nat'l. Wichita 2, Kansas
Character of Well (completed as Oil, Gas or Dry Hole) Dry Hole
Date well completed September 6 19 53
Application for plugging filed September 6 19 53
Application for plugging approved September 6 19 53
Plugging commenced September 6, 19 53
Plugging completed September 6, 19 53
Reason for abandonment of well or producing formation Dry

If a producing well is abandoned, date of last production. _____ 19 ____
Was permission obtained from the Conservation Division or its agents before plugging was commenced? Yes

Name of Conservation Agent who supervised plugging of this well Mr. M. A. Rives
Producing formation _____ Depth to top _____ Bottom _____ Total Depth of Well 3906 Feet
Show depth and thickness of all water, oil and gas formations.

OIL, GAS OR WATER RECORDS

CASING RECORD

FORMATION	CONTENT	FROM	TO	SIZE	PUT IN	PULLED OUT
				8 5/8	217'	None

Describe in detail the manner in which the well was plugged, indicating where the mud fluid was placed and the method or methods used in introducing it into the hole. If cement or other plugs were used, state the character of same and depth placed, from _____ feet to _____ feet for each plug set.
Filled hole w/heavy mud plug at 210' w/20 sacks cement Plug 40' down w/ 10 sacks cement at surf.

9-15-53

RECEIVED
CONSERVATION DIVISION

(If additional description is necessary, use BACK of this sheet)

Name of Plugging Contractor Greenland Drilling Company
Address 506 Union Nat'l. Bank Bldg. Wichita, Kansas

STATE OF KANSAS, COUNTY OF SEDGWICK, ss.
Richard S. Davis (employee of owner) or (owner or operator) of the above-described well, being first duly sworn on oath, says: That I have knowledge of the facts, statements, and matters herein contained and the log of the above-described well as filed and that the same are true and correct. So help me God.

(Signature) [Signature]
506 Union Nat'l Wichita, Kansas
(Address)

SUBSCRIBED AND SWORN TO before me this 14th day of September, 19 53

My commission expires July 8, 1957

Mary Ellen Cummins
Notary Public.

24-7366-6 3-53-20M

PLUGGING
FILE SEC 35 T 22 R 14W
BOOK PAGE 127 LINE 15

WELL LOG

Company: Greenland Drilling Co., et al
 Name: Ratts #1
 Total Depth: 3906'
 Comm: 8-27-53
 Comp: 9-6-53
 Casings: 217' of 8 5/8"

Sec: 35 T 22S R 11W
 Loc: SE SE NW
 County: Stafford
 Elev: 1938 DF 1941 KB
 Production: D & A

Figures Indicate Bottom of Formations

165	Sand & Clay		
185	Shale		
217	Shale & Shells		
250	Shale & sand		
310	Red Bed		
400	Sand		
844	Red Bed		
850	Anky.		
1115	Sand, Shells, shale		
1210	Shale & shells		
1510	Shale, lime w/salt		
1855	Shale & lime		
2125	lime w/sh breaks		
2230	Shale & lime		
2365	Sgy. shale & lime		
2665	Shale & lime		
2820	Shaled lime		
3225	Limed shale		
3300	lime w/shale brks.		
3316	lime & shale		
3350	Shale		
3390	Limed shale		
3460	Shaled lime		
3490	lime & shale		
3718	lime		
3805	lime & shale		
3818	lime		
3860	Sing. shale & sd.		
3906	Arb.		
3906	T.D.		

	<u>Tops</u>	
	Reelner	3315
	Brown Lime	3477
	Lansing	3490
	Base K.C.	3718
	Viola	3782
	Simpson	3831
	Artuckle	3881

	DST	3600 - 3620
		Open 30 minutes, shut in 20
		minutes, work blow 6 minutes,
		recovered 15 feet mud with
		specks of oil.
		RRP 11209

State of Kansas)
 County of Sedgwick) ss.

I, Richard S. Davis of the Greenland Drilling Company upon oath state that the above and foregoing is a true and correct copy of the log of the Ratts #1 well.

RECEIVED
 STATE CORPORATION COMMISSION
 SEP 13 1953
 CONSERVATION DIVISION
 Wichita, Kansas

Richard S. Davis
 Richard S. Davis

Subscribed and sworn to before me this 8th day of September, 1953.

Marie Ellen Cummings
 Notary Public

My Commission Expires: July 7 1957

PLUGGING
 FILE SEC 35 T 22 R 14W
 BOOK PAGE 127 LINE 15