


15-155-19039-0000

Form CP-4

STATE OF KANSAS  
STATE CORPORATION COMMISSION  
Give All Information Completely  
Make Required Affidavit  
Mail or Deliver Report to:  
Conservation Division  
State Corporation Commission  
211 No. Broadway  
Wichita, Kansas

# WELL PLUGGING RECORD

Reno County. Sec. 21 Twp. 23 Rge. 10 (E) (W)  
Location as "NE/CNWxSWx" or footage from lines W/2 NE/4  
Lease Owner Fell & Wolf Oil Co.  
Lease Name Snowbarger Well No. I  
Office Address Box 7447 Tulsa, Oklahoma  
Character of Well (completed as Oil, Gas or Dry Hole) oil  
Date well completed 8-21 1941  
Application for plugging filed April 1966  
Application for plugging approved April 1966  
Plugging commenced 4-6 1966  
Plugging completed 4-13 1966  
Reason for abandonment of well or producing formation \_\_\_\_\_

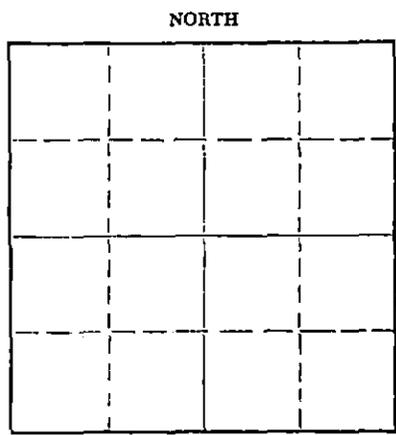

Locate well correctly on above Section Plat

If a producing well is abandoned, date of last production \_\_\_\_\_ 19\_\_\_\_  
Was permission obtained from the Conservation Division or its agents before plugging was commenced? Yes

Name of Conservation Agent who supervised plugging of this well Gilbert Toman  
Producing formation \_\_\_\_\_ Depth to top \_\_\_\_\_ Bottom \_\_\_\_\_ Total Depth of Well 3784' Feet  
Show depth and thickness of all water, oil and gas formations.

## OIL, GAS OR WATER RECORDS

## CASING RECORD

FORMATION	CONTENT	FROM	TO	SIZE	PUT IN	PULLED OUT
				5 1/2"		3,078'

Describe in detail the manner in which the well was plugged, indicating where the mud fluid was placed and the method or methods used in introducing it into the hole. If cement or other plugs were used, state the character of same and depth placed, from \_\_\_\_\_ feet to \_\_\_\_\_ feet for each plug set.

Plugged off bottom of hole with rock. Rock from 3784' to 3750'. Dumped 5 sx of cement. Mudded hole to 185'. Made 10' of rock bridge. Dumped 20 sx of cement. Mudded hole to 35'. Made 5' of rock bridge. Dumped 10 sx of cement, filling to the bottom of the cellar.

RECEIVED  
STATE CORPORATION COMMISSION

APR 20 1966

CONSERVATION DIVISION  
Wichita, Kansas

(If additional description is necessary, use BACK of this sheet)

Name of Plugging Contractor Art Lamb Casing Pulling Co.  
Address 2809 King Hutchinson, Kansas

STATE OF Kansas, COUNTY OF Reno, ss.  
Art Lamb (employee of owner) or (owner or operator) of the above-described

well, being first duly sworn on oath, says: That I have knowledge of the facts, statements, and matters herein contained and the log of the above-described well as filed and that the same are true and correct. So help me God.

(Signature) Art Lamb

2809 King Hutchinson, Kansas  
(Address)

SUBSCRIBED AND SWORN TO before me this 16 th day of April, 1966

My commission expires January 5, 1970

Judy Lamb  
Notary Public.

## CORING LOG

15-155-19039-0000

## REPUBLIC NATURAL GAS COMPANY

Lease SnowbargerWell No. 1Total Depth 3784'Comm. 8-6-41 Comp. 8-21-41

Shot or Treated \_\_\_\_\_

Contractor Simson Noble, Inc.

Rotary T. D. \_\_\_\_\_

Cable Tools From \_\_\_\_\_ To \_\_\_\_\_

County Reno  
 Sec. 21 Twp. 23 Rge. 10  
 Location W/2 NE/4  
 Elevation 1778'

## CASING:

5 1/2" set at 3765  
 8 5/8" set at 184' 5"

Figures Indicate Bottom of Formations:

0 - 181		2991 - 3058	Broken Line
181 - 200		3058 - 3087	" "
200 - 423	Red Beds	3087 - 3128	" "
423 - 480	" "	3128 - 3175	" "
480 - 715	Shale & shells	3175 - 3218	Shale
715 - 915	" " "	3218 - 3302	"
915 - 990	" " "	3302 - 3320	"
990 - 1210	" " " & salt	3320 - 3346	Broken Line
1210 - 1390	" " Lime, shells	3346 - 3409	Lime
1390 - 1497	Broken Lime	3409 - 3435	Hard Lime
1497 - 1530	" "	3435 - 3507	Hackberry C. Lime
1530 - 1642	Sandy shale & Lime shells	3507 - 3560	Lime
1642 - 1690	Sandy Shale	3560 - 3588	"
1690 - 1705	Shale & chert	3588 - 3615	Shale
1705 - 1721	Broken Lime and shale	3615 - 3625	Shale, Brown & Blue
1721 - 1824	Broken Lime	3625 - 2643	Broken Shale & Chert
1824 - 1840	" "	3643 - 3644	Chert
1840 - 1867	Shale	3644 - 3673	Shale
1867 - 1884	Shale & Broken Lime	3673 - 3735	"
1884 - 1900	Lime	3735 - 3763	"
1900 - 2020	Broken Lime & Shale	3763 - 3765	Broken Shale
2020 - 2161	Broken Lime & Shale	3765 - 3772	" "
2161 - 2217	Shale & Shells	3772 -	T. D.
2217 - 2388	Shale		
2388 - 2520	"		
2520 - 2545	"		
2545 - 2565	Lime		
2565 - 2655	Broken Lime		
2655 - 2715	" "		
2715 - 2734	Lime		
2734 - 2835	Broken Lime		
2835 - 2900	" "		
2900 - 2991	" "		

(SEE OVER FOR CORING RECORD)