


STATE OF KANSAS
STATE CORPORATION COMMISSION

Give All Information Completely
Make Required Affidavit
Mail Deliver Report to:
Conservation Division
State Corporation Commission
800 Building
Wichita, Kansas

15-155-02867-0006 WELL PLUGGING RECORD

NORTH

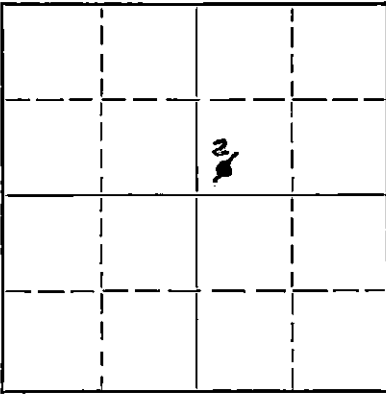

Locate well correctly on above
Section Plat

Reno County, Sec. 21 Twp. 23S. Rge. 10W (E) (W)
Location as "NE/CNW $\frac{1}{4}$ SW $\frac{1}{4}$ " or footage from lines SW $\frac{1}{4}$ SW $\frac{1}{4}$ NE $\frac{1}{4}$
Lease Owner Republic Natural Gas Company
Lease Name Snowbarger "B" Well No. 2
Office Address Box 126, Ellinwood, Kansas
Character of Well (completed as Oil, Gas or Dry Hole) Oil
Date well completed 9-25-41 19...
Application for plugging filed 7-8-53 19...
Application for plugging approved 7-9-53 19...
Plugging commenced 7-11-53 19...
Plugging completed 7-17-53 19...
Reason for abandonment of well or producing formation Depleted
If a producing well is abandoned, date of last production March 1953 19...
Was permission obtained from the Conservation Division or its agents before plugging was commenced? Yes

Name of Conservation Agent who supervised plugging of this well Ruel E. Durkee
Producing formation Viola Depth to top 3761 Bottom ? Total Depth of Well 3785 Feet
Show depth and thickness of all water, oil and gas formations.

OIL, GAS OR WATER RECORDS

CASING RECORD

Formation	Content	From	To	Size	Put In	Pulled Out
				8-5/8"	185'	None
				5-1/2"	3764'	3100'
Kansas City-Lansing	Water	3296	3566			
Missippi Lime	Water	3600	3630			
Viola Lime	Oil	3761	3758 TD			

Describe in detail the manner in which the well was plugged, indicating where the mud fluid was placed and the method or methods used in introducing it into the hole. If cement or other plugs were used, state the character of same and depth placed, from _____ feet to _____ feet for each plug set.

Cast iron bridge plug at 3330'
Plug back with sand to 3305'
Cement plug with cement to 3285'
Mud to 195'
Crushed rock to 185'
Cement to 160'
Mud to 15'
Cement to top surface casing.

7-21-53

RECEIVED
STATE CORPORATION COMMISSION

JUL 21 1953

CONSERVATION DIVISION
WICHITA, KANSAS

Name of Plugging Contractor Ace Pipe Pulling Company
Address Great Bend, Kansas

STATE OF Kansas, COUNTY OF Barton, ss.
K. J. Boone (employee of owner) or (Special Agent) of the above-described well,
being first duly sworn on oath, says: That I have knowledge of the facts, statements, and matters herein contained and the log of the above-described well as filed and that the same are true and correct. So help me God.

(Signature) *K. J. Boone*

Box 126, Ellinwood, Kansas
(Address)

SUBSCRIBED AND SWORN TO before me this 20th day of July, 1953.

Allen Mac Benschutt
Notary Public.

My commission expires 8-30-55

23-8390-s 6-51-20M

PLUGGING
FILE SEC 21 T 23 R 10W
BOOK PAGE 113 LINE 23

DRILLING LOG

15-155-02867-0000

Company: Republic Natural Gas Company
Lease and Well: Snowbarger B-2
Location: SWSW NE Section 21-23S-10W
County: Reno County, Kansas
Commenced: 8-9-41
Completed: 9-24-41

0 - 100	Clay & Shells
100 - 182	Red Rock and Shells
182 - 205	Red Rock
205 - 240	Sand
240 - 475	Shale and Shells
475 - 857	Red Bed Shale and Shells
857 - 1095	Shale and Shells
1095 - 1125	Shale
1125 - 1300	Salt
1300 - 1380	Shale
1380 - 1475	Shale and Shells
1475 - 1514	Anhydrite
1514 - 1614	Anhydrite Lime and Shale
1614 - 1650	Shale
1650 - 1808	Lime
1808 - 2375	Lime and Shale
2375 - 2497	Lime, Shells and Shale
2497 - 2530	Lime
2530 - 2565	Shale and Lime
2565 - 2620	Lime
2620 - 2810	Broken Lime
2810 - 3170	Lime
3170 - 3212	Lime and shale
3212 - 3296	Shale
3296 - 3372	Shale and Lime
3372 - 3420	Lime
3420 - 3491	Broken Lime
3491 - 3630	Lime
3630 - 3639	Chert
3639 - 3687	Shale and Red Beds
3687 - 3761	Shale
3761 - 3765	Chert and Lime
3765	R.T.D.

Casing: 185' 8-5/8" OD
3764' 5-1/2" OD

