


WELL PLUGGING RECORD

Give All Information Completely
Make True Affidavit
Mail or Deliver Report to:
Conservation Division
State Corporation Commission
800 Bitting Building
Wichita, Kansas

NORTH

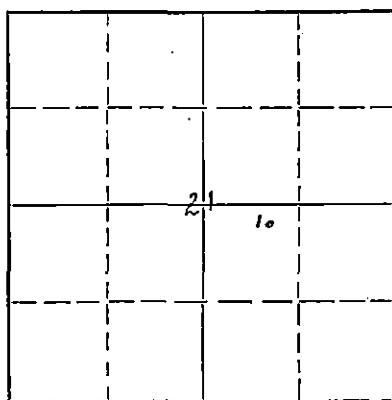

Locate well correctly on above
Section Plat

Reno County. Sec. 21 Twp. 23 Rge. 10 (E) W (W)
Location as "NE/CNW%SW%" or footage from lines 330' S. & 990' E. of Cen.
Lease Owner Cities Service Oil Company
Lease Name Kreie "B" Well No. 1
Office Address Great Bend, Kansas
Character of Well (completed as Oil, Gas or Dry Hole) Oil Well
Date well completed August 19, 19 54
Application for plugging filed August 2, 19 54
Application for plugging approved August 3, 19 54
Plugging commenced August 16, 19 54
Plugging completed August 22, 19 54
Reason for abandonment of well or producing formation Depleted formation

If a producing well is abandoned, date of last production July 27, 19 54
Was permission obtained from the Conservation Division or its agents before plugging was commenced? Yes

Name of Conservation Agent who supervised plugging of this well Ruel Durkee
Producing formation Viola Depth to top 3778 Bottom 3794 Total Depth of Well 3794 Feet
Show depth and thickness of all water, oil and gas formations.

OIL, GAS OR WATER RECORDS

CASING RECORD

FORMATION	CONTENT	FROM	TO	SIZE	PUT IN	PULLED OUT
				10-3/4"	347'	None
				5-1/2"	3782'	1728'

Describe in detail the manner in which the well was plugged, indicating where the mud fluid was placed and the method or methods used in introducing it into the hole. If cement or other plugs were used, state the character of same and depth placed, from _____ feet to _____ feet for each plug set.

3794-3770, sand
3770-3722, 6 sacks cement
3722- 265, mud
265- 250, rock bridge
250- 200, 20 sacks cement
200- 20, mud.
20' to base of cellar, 5 sacks cement.

(If additional description is necessary, use BACK of this sheet)

Name of Plugging Contractor B. & W. Casing Pulling Company
Address 37 South Kansas, Russell, Kansas

STATE OF Kansas, COUNTY OF Barton, ss.
O. C. Atkinson (employee of owner) of the above-described well, being first duly sworn on oath, says: That I have knowledge of the facts, statements, and matters herein contained and the log of the above-described well as filed and that the same are true and correct. So help me God.

(Signature) O. C. Atkinson
Box 751 1/2 Great Bend, Kansas
(Address)

SUBSCRIBED AND SWORN to before me this 25th day of August, 19 54

My commission expires March 12, 1955.

W. B. Smith
Notary Public.
STATE CORPORATION COMMISSION

24-7366-B 3-53-20M

PLUGGING
FILE SEC 21 T 23 R 10W
BOOK PAGE 53 LINE 25

AUG 1 1954
8-31-54
CONSERVATION DIVISION
Wichita, Kansas

Company Cities Service Oil Co. Well No. 1 Farm Kreis "B"
 Location 330' south & 990' east of center Sec. 21 T. 23 R. 10-W
 Elevation 1788 County Reno State Kansas
 Drlg. Comm. July 31, 1941 Contractor Hessom Drilling Company
 Drlg. Comp. August 19, 1941 Acid None
 T. D. 3794' Initial Prod. B. H. P. Bomb Potential: 3000 oil, no water, 24 hours
 (Indicated Capacity 100,000 bbls.)

CASING RECORD:

10-3/4" @ 347' con. 225 sz cement
 5-1/2" @ 3782' con. 85 sz Dewey

Corr. Top Viola 3778
 Penetration 16'
 Total Depth 3794

FORMATION RECORD:

surface clay, sand & shells 0-54
 red bed & shells 245
 red bed & sand 330
 shells 347
 red bed & shells 535
 shale & shells 1020
 salt & shells 1130
 shale & salt 1425
 shale & lime 1905
 sandy lime & shale 2293
 broken lime & shale 2387
 broken lime 2504
 broken lime & shale 2645
 lime 2668
 shale 2699
 lime & shale 2760
 sandy shale 2815
 lime 2883
 broken lime & shale 2942
 lime 3072
 lime & shale 3194
 shale 3235
 shale & shells 3314
 lime 3601
 lime & shale 3618
 lime & chert 3640
 lime 3673
 shale 3716
 blue & grey shale, sticky 3755
 shale 3769
 lime 3774

Loaded hole with 2500' water;
 hole filled additional 500'
 while drilling-in. 3000' fluid
 in hole.

Syfo: 500' OK
 1000' OK
 1500' OK
 2000' OK
 2500' OK
 3000' OK
 3500' OK

3774 Rot. T. D. = 3782 S. L. W.
 lime 3794 T. D.

RECEIVED
 STATE CORPORATION COMMISSION
 AUG 25 - 1941
 CONSERVATION DIVISION

PLUGGING
 FILE SEC 21 T 23 R 10W
 BOOK PAGE 53 LINE 25