

15-155-02115-0000

STATE OF KANSAS
STATE CORPORATION COMMISSION


WELL PLUGGING RECORD

Give All Information Completely
Make Required Affidavit
Mail or Deliver Report to:
Conservation Division
State Corporation Commission
800 Bitting Building
Wichita, Kansas

OR
FORMATION PLUGGING RECORD

Strike out upper line
when reporting plug-
ging off formations.

NORTH

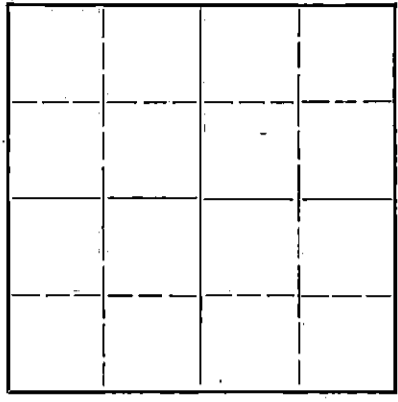

Locate well correctly on above
Section Plat

Reno County. Sec. 23 Twp. 23 Rge. (E) 10 (W)
Location as "NE 1/4 NW 1/4 SW 1/4" or footage from lines C 40 NW 1/4 NE 1/4
Lease Owner Lion Oil Refining Co.
Lease Name Blaine Well No. 2
Office Address El Dorado, Arkansas
Character of Well (completed as Oil, Gas or Dry Hole) Dry Hole
Date well completed Nov. 27 19 42
Application for plugging filed Nov. 27 19 42
Application for plugging approved Nov. 27 19 42
Plugging commenced Nov. 27 19 42
Plugging completed Nov. 28 19 42
Reason for abandonment of well or producing formation Dry Hole

If a producing well is abandoned, date of last production 19
Was permission obtained from the Conservation Division or its agents before plugging was com-
menced? Yes

Name of Conservation Agent who supervised plugging of this well RUEH DURKEE
Producing formation! Depth to top Bottom Total Depth of Well 3790' Feet

Show depth and thickness of all water, oil and gas formations.

OIL, GAS OR WATER RECORDS				CASING RECORD		
Formation	Content	From	To	Size	Put In	Pulled Out
				9 5/8"	260'	none

Describe in detail the manner in which the well was plugged, indicating where the mud fluid was placed and the method or methods used in introducing it into the hold. If cement or other plugs were used, state the character of same and depth placed, from feet to feet for each plug set.
10 Sacks Cement at 200' + 10 Sacks at top. Heavy mud pumped in at 1900'

PLUGGING
FILE SEC 23-T-23-R10-W
BOOK PAGE 57 LINE 25

12-5-42

(If additional description is necessary, use BACK of this sheet)
Correspondence regarding this well should be addressed to Lion Oil Refining Co.
Address El Dorado, Arkansas

STATE OF Kansas, COUNTY OF Reno, SS.
Vernon Hayes (employee of owner) or (owner or operator) of the above-described well, being first duly sworn on oath, says: That I have knowledge of the facts, statements, and matters herein contained and the log of the above-described well as filed and that the same are true and correct. So help me God.

(Signature) Vernon Hayes
Hutchinson, Kan. 3108 W. Walnut.
(Address)

SUBSCRIBED AND SWORN to before me this 4th day of December, 1942

My commission expires Nov 4, 1943
Walter R. Ribbenroek
Notary Public.

15-155-0215-0000

Lion Oil Refining Company

Blaine Well No. 2 145' North of Center of West 40 acres of N/2 of NE/4,
Sec. 23, Twp. 23S, Rge. 10 W., Reno County, Kansas

Elevation

Contractor: The R. W. Rine Drilling Co.

Commenced Nov. 13, 1942 Completed Nov. 28, 1942

LOG

Red Beds and Shale	Top - 258	9 5/8" casing cemented at 258'
Red Beds	258 - 363	
Red Beds and Shale	363 - 700	
Shale and Shells	700 - 1040	
Salt and Shale	1040 - 1313	
Shale and Lime	1313 - 1510	
Shells and Shale	1510 - 1535	
Shale and Lime	1535 - 1630	
Shale and Shells	1630 - 1770	
Sandy Lime	1770 - 1870	
Lime	1870 - 1940	
Shale and Lime	1940 - 2050	
Shale	2050 - 2640	
Lime and Shale	2640 - 2775	
Shale	2775 - 2850	
Lime	2850 - 2975	
Shale	2975 - 3025	
Lime	3025 - 3045	
Broken Lime	3045 - 3200	
Lime	3200 - 3275	
Shale	3275 - 3310	
Lime	3310 - 3445	
Broken Lime and Shale	3445 - 3485	
Lime and Shale	3485 - 3541	
Lime	3541 - 3589	
Lime and Shale	3589 - 3614	
Chert	3614 - 3630	
Lime, Shale & Chert	3630 - 3659	Top Viola Lime, 3790'
Shale	3659 - 3780	
Lime	3780 - 3788	Total Depth 3791'
CORRECTION	3788 equals	3791 Dry hole. Plugged and abandoned.

PLUGGING
FILE SEC 23 T 23 R 10 W
BOOK PAGE 57 LINE 25

State of Kansas)
County of Barton) ss.

I, C. H. Todd, do hereby certify that the above is a true and correct copy of the log of Blaine Well No. 2, located 145' north of the center of the west 40 acres of the North Half of Northeast Quarter of Sec. 23, Twp. 23S, Rge. 10W, Reno County, Kansas.

C. H. Todd

Sworn to and subscribed before me this 2nd day of December, 1942.

C. O. Deighton
Notary Public

My commission expires December 4th, 1943