

FOR KCC USE:

FORM C-1 7/91

EFFECTIVE DATE

11-21-93

State of Kansas

FORM MUST BE TYPED

DISTRICT# 3

NOTICE OF INTENTION TO DRILL

FORM MUST BE SIGNED

SGA?...Yes...No

Must be approved by the K.C.C. five (5) days prior to commencing well

ALL BLANKS MUST BE FILLED

EXPECTED SPUD DATE: 11 18 93
month day year

Spot EE EAST
NE SW NE SE Sec 18 Twp 26 S, Rg 22 WEST

Operator: License#: 31028
Name: INTEGRATED PETROLEUM CORP
Address: 1801 BROADWAY, SUITE #320
City/State/Zip: DENVER CO. 80202
Contact Person: JEFF GALEMORE
Phone: 303-297-8720

1880 feet from (South) / North Line of Section
850 feet from (East) / West Line of Section
IS SECTION XX REGULAR IRREGULAR?

CONTRACTOR: License # 06451
Name: BIG-E DRILLING

NOTE: Locate well on the Section Plat on Reverse Side)
COUNTY: BOURBON
LEASE NAME: JK WELL#: 18-37

Field Name: SAVONBERG
Is this a Prorated/Spaced Field? yes XX no

Target Formation(s): BARTLESVILLE
Nearest lease or unit boundary: 850

Ground Surface Elevation: NA feet MSL

Water well within one-quarter mile: yes XX no

Public water supply well within one mile: yes XX no

Depth to bottom of fresh water: 25

Depth to bottom of usable water: 100

Surface Pipe by Alternate: 1 XX 2

Length of Surface Pipe Planned to be set: 20

Length of Conductor Pipe required: NONE

Projected Total Depth: 700

Formation at Total Depth: BARTLESVILLE

Water Source for Drilling Operations:
well farm pond XX other

DWR Permit# _____

Will Cores Be Taken? yes XX no

If yes, proposed zone: _____

Well Drilled For: Well Class: Type Equipment:

XX Oil Enh Rec XX Infield XX Mud Rotary
Gas Storage Pool Ext. Air Rotary
OWWO Disposal Wildcat Cable
Seismic; # of Holes Other
Other

If OWWO: old well information as follows:

Operator: _____

Well Name: _____

Comp. Date: _____ Old Total Depth _____

Directional, Deviated or Horizontal wellbore? yes XX no

If yes, true vertical depth: _____

Bottom Hole Location _____

AFFIDAVIT

RECEIVED

KANSAS CORPORATION COMMISSION

The undersigned hereby affirms that the drilling, completion and eventual plugging of this well will comply with K.S.A. 55-101 et. seq.

It is agreed that the following minimum requirements will be met:

NOV 15 1993

1. Notify the appropriate district office prior to spudding of well.
2. A copy of the approved notice of intent to drill shall be posted on each drilling rig.
3. The minimum amount of surface pipe as specified below shall be set by circulating cement to the top. In all cases surface pipe shall be set through all unconsolidated materials plus a minimum of 20 feet into the producing formation.
4. If the well is dry hole, an agreement between the operator and district office on plug length and placement is necessary prior to plugging.
5. The appropriate district office will be notified before well is either plugged or production casing is cemented in.
6. IF AN ALTERNATE II COMPLETION, PRODUCTION PIPE SHALL BE CEMENTED FROM BELOW ANY USABLE WATER TO SURFACE WITHIN (120) DAYS OF SPUD DATE. IN ALL CASES, NOTIFY DISTRICT OFFICE PRIOR TO ANY CEMENTING.

I hereby certify that the statements made herein are true and to the best of my knowledge and belief.

Date: 11/15/93 Signature of Operator or Agent: Marilyn E. [Signature] Title: AGENT
SEARCH INC., 316-265-5415

1009

FOR KCC USE: 011-22812-0000
 API # 15-
 Conductor Pipe required NONE feet
 Minimum surface pipe required 20 feet per Alt. XC
 Approved by: CB 11-16-93
 This Authorization expires: 5-16-94
 (This authorization void if drilling not started within 6 months of effective date.)
 Spud date: _____ Agent: _____

REMEMBER TO:

- File Drill Pit Application (form CDP-1) with intent to Drill;
- File Completion Form ACO-1 within 120 days of spud date;
- File acreage attribution plat according to field proration orders;
- Notify appropriate district office 48 hour prior to workover or re-entry;
- Submit plugging report (CP-4) after plugging is completed;
- Obtain written approval before disposing or injecting salt water.

Mail to: Conservation Division, 200 Colorado Derby Building, 202 W. First St., Wichita, Kansas 67202-1286.

18
26
22

IN ALL CASES PLOT THE INTENDED WELL ON THE PLAT BELOW

PLAT OF ACREAGE ATTRIBUTABLE TO A WELL IN A PRORATED OR SPACED FIELD

If the intended well is in a prorated or spaced field, please fully complete this side of the form. If the intended well is in a prorated or spaced field complete the plat below showing that the well will be properly located in relationship to other wells producing from the common source of supply. Please show all the wells within 1 mile of the boundaries of the proposed acreage attribution unit for gas wells and within 1/2 mile of the boundaries of the proposed acreage attribution unit for oil wells.

API NO. 15- _____
 OPERATOR _____
 LEASE _____
 WELL NUMBER _____
 FIELD _____



LOCATION OF WELL: COUNTY _____
 _____ feet from (South) / North Line of Section
 _____ feet from (East) / West line of section
 SECTION _____ TWP _____ RG _____

ACRES ATTRIBUTABLE TO WELL _____
 QTR/QTR/QTR OF ACREAGE _____

IS SECTION XX REGULAR or _____ IRREGULAR
IF SECTION IS IRREGULAR, LOCATE WELL FROM NEAREST CORNER BOUNDARY
 Section corner used: _____ NE _____ NW _____ SE _____ SW

PLAT

(Show location of the well and shade attributable acreage for prorated or spaced wells.)
 (Show footage to the nearest lease or unit boundary line.)

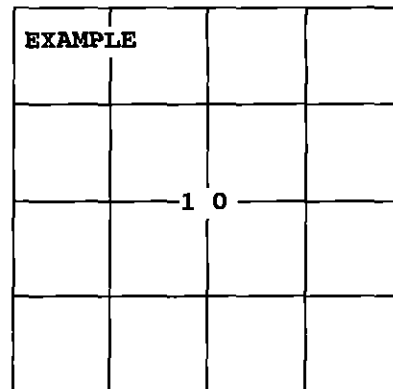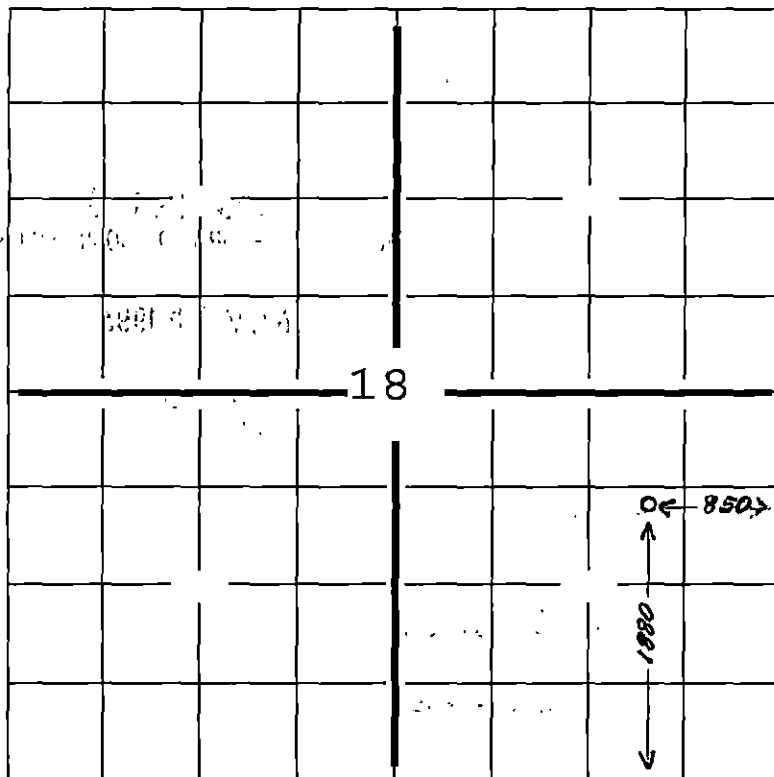

SEWARD CO.

In plotting the proposed location of the well, you must show:

- 1) The manner in which you are using the depicted plat by identifying section lines, i.e. 1 section, 1 section with 8 surrounding sections, 4 sections, etc.;
- 2) the distance of the proposed drilling location from the section's south/north and east/west lines; and
- 3) the distance to the nearest lease or unit boundary line.