


STATE OF KANSAS
STATE CORPORATION COMMISSION
CONSERVATION DIVISION
P. O. BOX 17027
WICHITA, KANSAS 67217

FORM CP-4

WELL PLUGGING RECORD

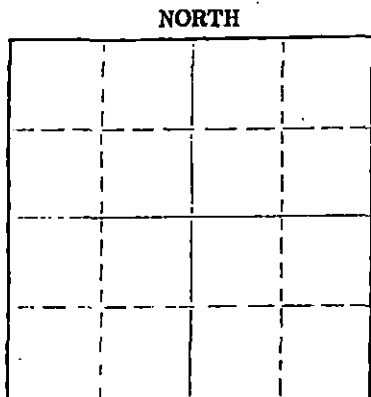

Locate well correctly on above
Section Plot

Pawnee County. Sec. 1 Twp. 22S Rge. 16W (W)
Location as "NE/CNW/SW" or footage from lines NW SW NE
Lease Owner Voyager Petroleum, Kansas-Nebraska Nat Gas, Sterling
Lease Name Evers Well No. 1 Drilling
Office Address P. O. Box 129, Sterling, Kansas 67579 Company
Character of Well (completed as Oil, Gas or Dry Hole) Dry Hole
Date well completed June 1, 1975 19
Application for plugging filed June 1, 1975 19
Application for plugging approved June 1, 1975 19
Plugging commenced 5:00 PM, June 1, 1975 19
Plugging completed 7:00 PM, June 1, 1975 19
Reason for abandonment of well or producing formation Dry Hole

If a producing well is abandoned, date of last production _____ 19____
Was permission obtained from the Conservation Division or its agents before plugging was commenced? Yes

Name of Conservation Agent who supervised plugging of this well Leo Massey
Producing formation _____ Depth to top _____ Bottom _____ Total Depth of Well 3935 Feet
Show depth and thickness of all water, oil and gas formations.

OIL, GAS OR WATER RECORDS

CASING RECORD

FORMATION	CONTENT	FROM	TO	SIZE	PUT IN	PULLED OUT
				8 5/8"	983'	None

Describe in detail the manner in which the well was plugged, indicating where the mud fluid was placed and the method or methods used in introducing it into the hole. If cement or other plugs were used, state the character of same and depth placed, from _____ feet to _____ feet for each plug set.

Filled hole with heavy mud.
25 sacks Cement at 300' through drill pipe;
heavy mud up to 40'. Halliburton plug at
40' and built bridge to hold Kelly.
10 sacks cement up to base of cellar. Put
2 sacks cement in rathole.

RECEIVED
JUN 5 1975

(If additional description is necessary, use BACK of this sheet)
Name of Plugging Contractor Sterling Drilling Company
Address P. O. Box 129, Sterling, Kansas 67579

STATE OF KANSAS COUNTY OF RICE ss.

F. A. Wuellner (employee of owner) or (owner or operator) of the above-described well, being first duly sworn on oath, says: That I have knowledge of the facts, statements, and matters herein contained and the log of the above-described well as filed and that the same are true and correct. So help me God. STERLING DRILLING COMPANY

(Signature) F. A. Wuellner
F. A. Wuellner, Secretary
P. O. Box 129, Sterling, Kansas 67579
(Address)

SUBSCRIBED AND SWORN TO before me this 14th day of June, 1975

My commission expires _____
Bernard Laudermilk
Bernard Laudermilk, Notary Public.

BERNARD LAUDERMILK—NOTARY PUBLIC
My Commission Expires Jan. 22, 1978

STERLING DRILLING COMPANY
P. O. Box 129
Sterling, Kansas 67579

WELL LOG ----- EVERS #1
Located: NW SW NE, Section 1-22S-16W, Pawnee County, Kansas

OWNER: Voyager Petroleum, Kansas-Nebraska Natural Gas, Sterling Drilling Co.
ROTARY DRILLING CONTRACTOR: Sterling Drilling Company

COMMENCED: May 20, 1975
COMPLETED: June 1, 1975

TOTAL DEPTH: 3935'

<u>LOG</u>	<u>CASING RECORD</u>
0 - 100 Sand and Clay	Ran 23 joints 8 5/8" 28# new seamless casing, 966.69' pipe set at 983.19 K.B. Cemented with 500 sacks Pozmix #1, 3% cc, plug down at 8:35 PM, 5-21-75.
100 - 640 Blue Shale	
640 - 840 Red Sand and Shale	
840 - 963 Anhydrite	
963 - 1780 Shale	
1780 - 2700 Lime and Shale	
2700 - 2785 Broken Lime	
2785 - 3035 Lime and Shale	
3035 - 3375 Lime	
3375 - 3497 Lime and Shale	
3497 - 3500 Brown Lime	
3500 - 3820 Lime	
3820 - 3875 Lime and Shale	
3875 - 3925 Lime, Shale, Sandy Chert	
3925 - 3932 Lime	
3932 - 3935 Arbuckle	Plugged.

JUN 5 1975